
SURVEY No. 924

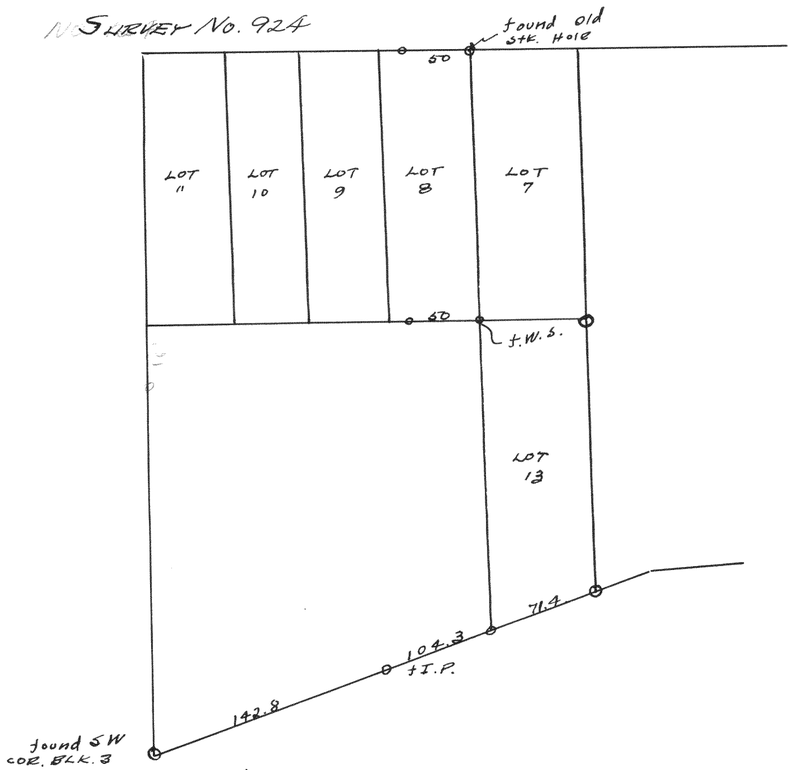


Survey of lot 8, 13 and 12 of Block 3 of the original plat of the Village of Wms. Bay

6-14-16-37

Lloyd L. Jensen by W.C.J.

SURVEY No. 925

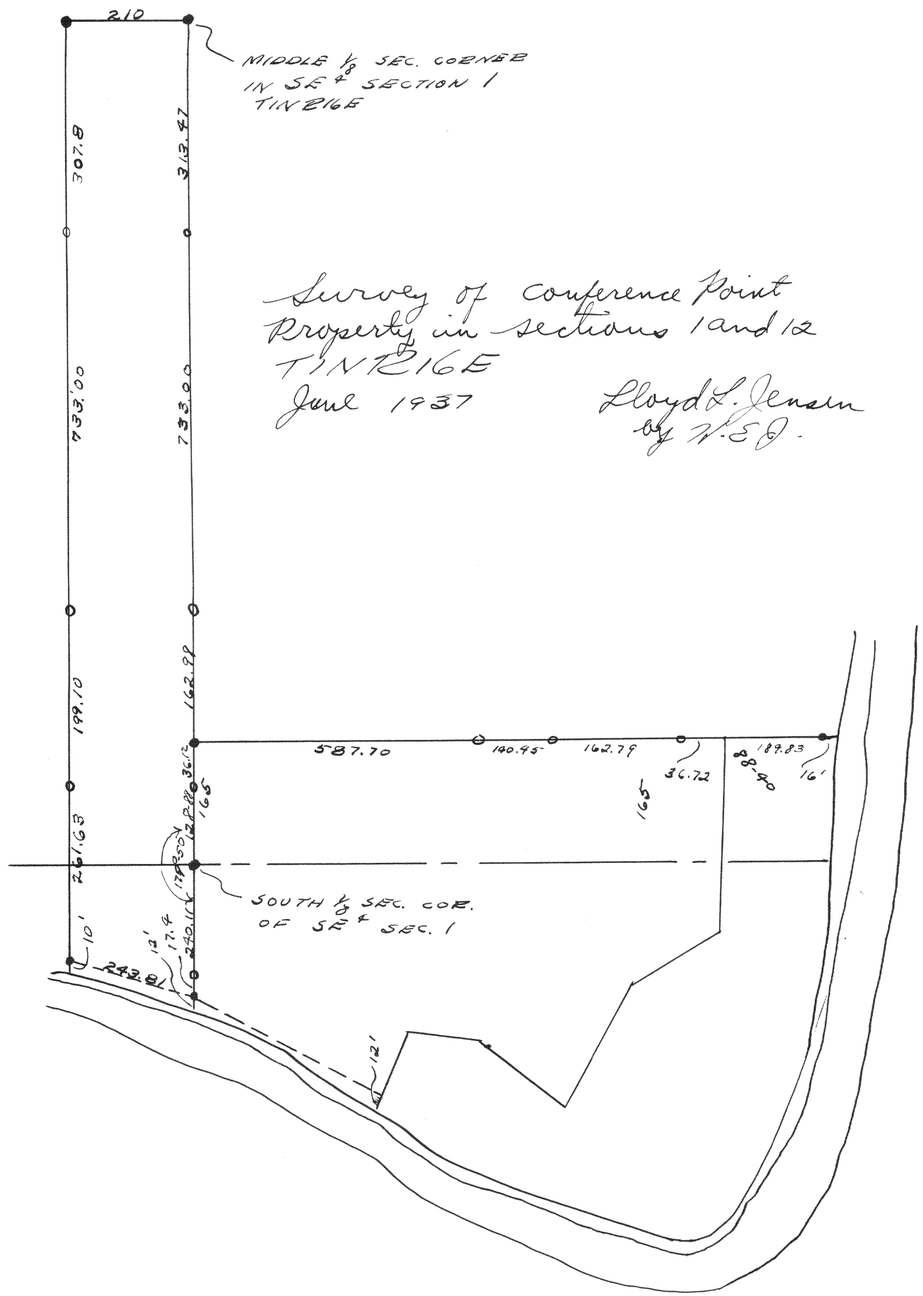

Survey of Conference Point Property in sections 1 and 12 T.11N.R.21E June 1937

Lloyd L. Jensen by W.C.J.