

SURVEY No. 926

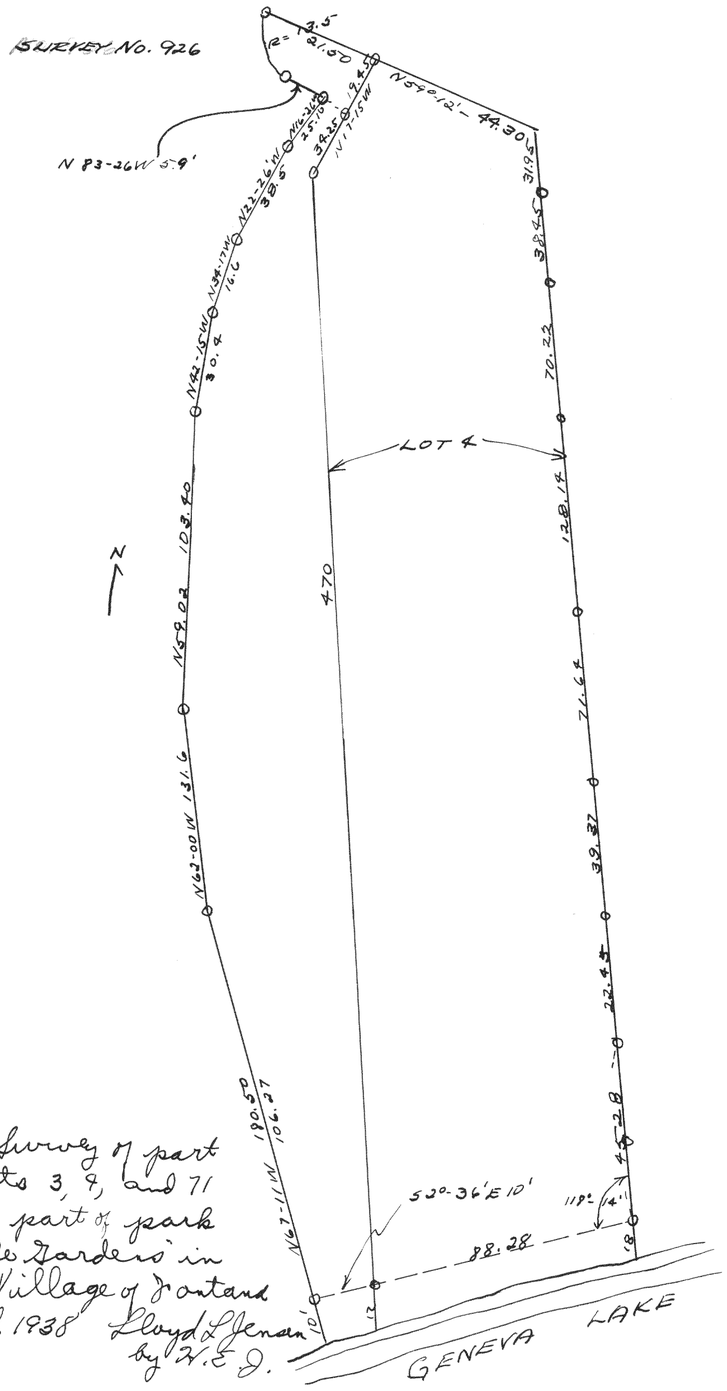

Survey of part of lots 3, 9, and 71 and part of park of "the Gardens" in the Village of Fontana April 1938 Lloyd L Jensen by K. E. D.

SURVEY No. 927

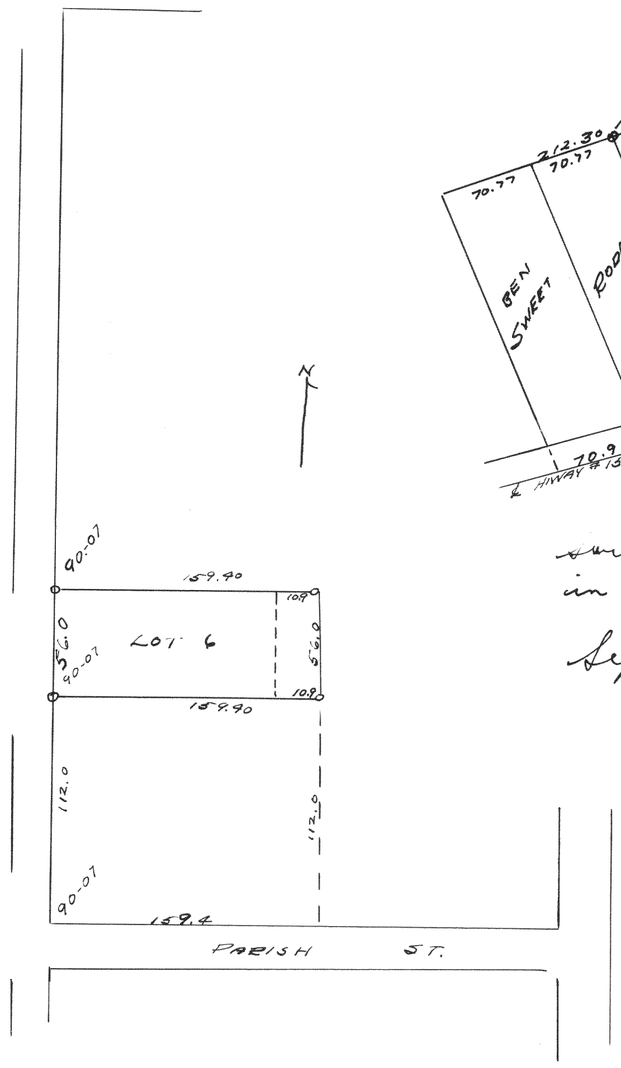


Survey of Lot 6. K. A. Lathrop's Second Addition to Delavan

11-3-38

Lloyd L. Jensen by K. E. D.

SURVEY No. 928

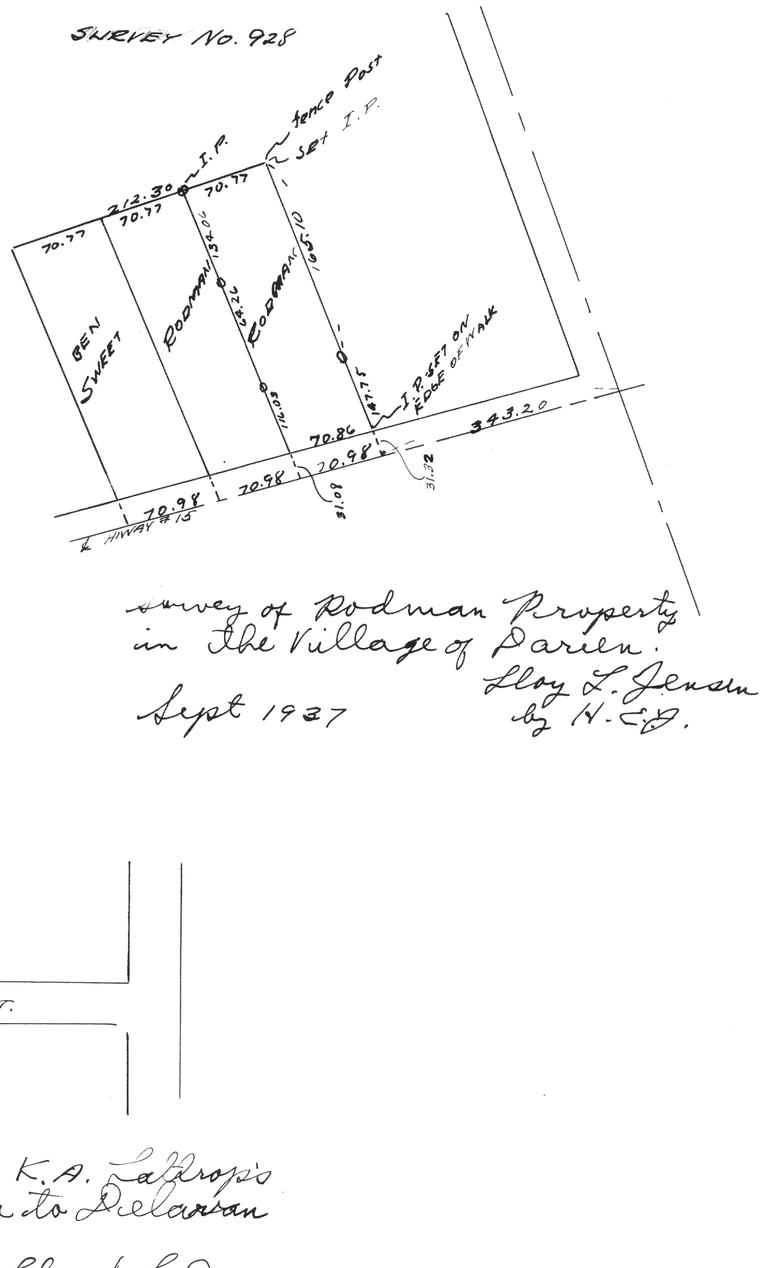

Survey of Rodman Property in the Village of Darien.

Sept 1937

Lloyd L. Jensen by K. E. D.