
SURVEY No. 936

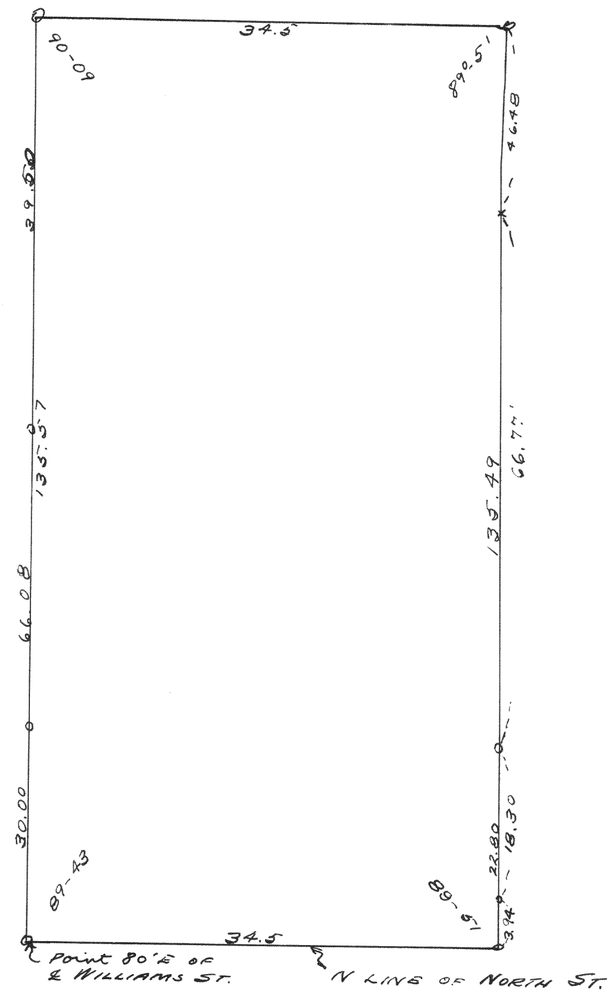


Survey of a parcel of land in
SW ¼ 25-2-17

May 1938

Lloyd L. Jensen
by H. E. J.

SURVEY No. 937

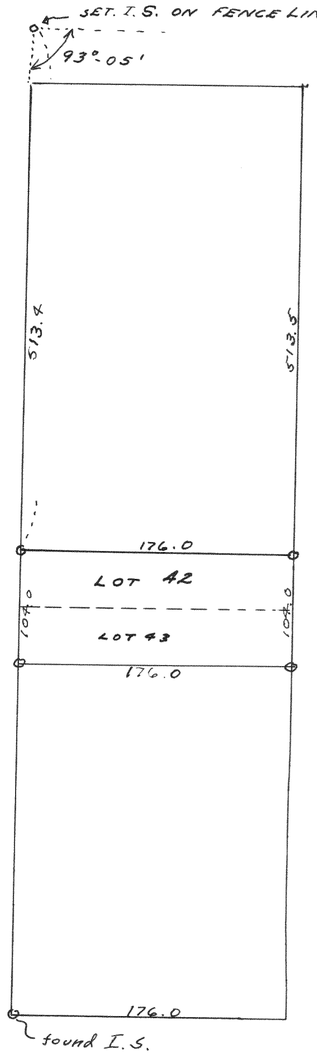


Survey of lots 42 & 43 of the
Shanahan Subd. in the Village
of Sharon

5-7-38

Lloyd L Jensen
by H.E.J.

SURVEY No. 938 .

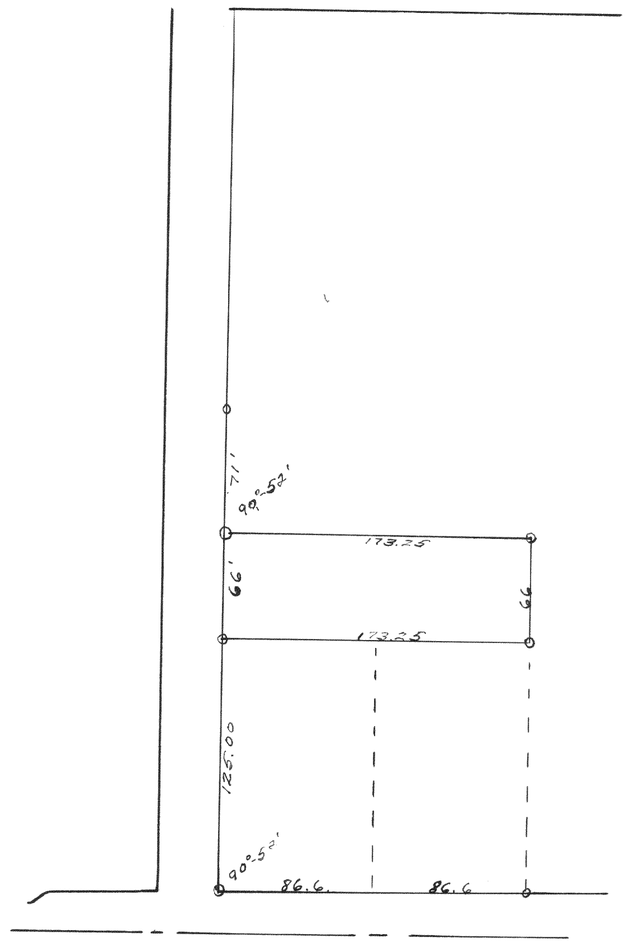

Survey of part of outlot 196
of the Assessors plat of
the Village of Warwick.