
SURVEY NO. 939

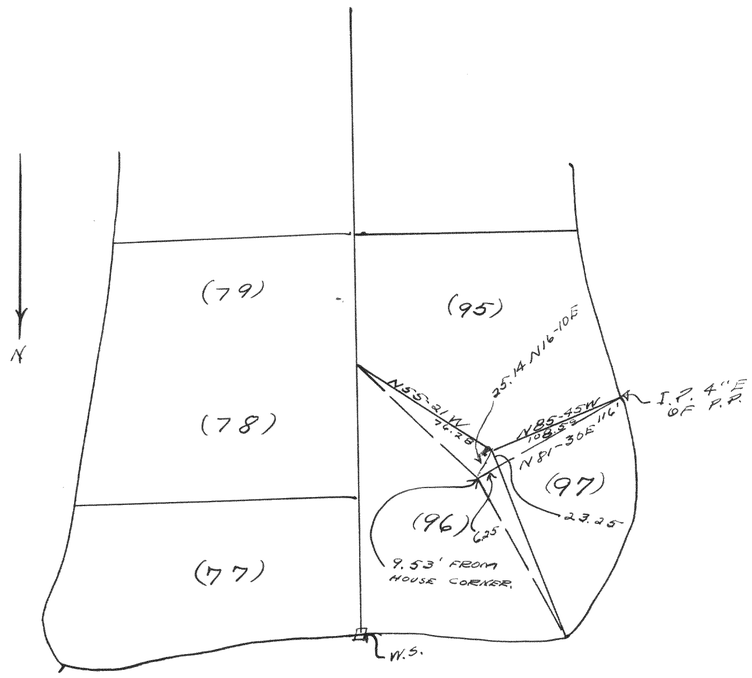


Survey of part of lots 95 96 & 97 of Unit 2 Country Club Estates

4-22-38

Lloyd L. Jensen
by K.E.D.

SURVEY NO. 940

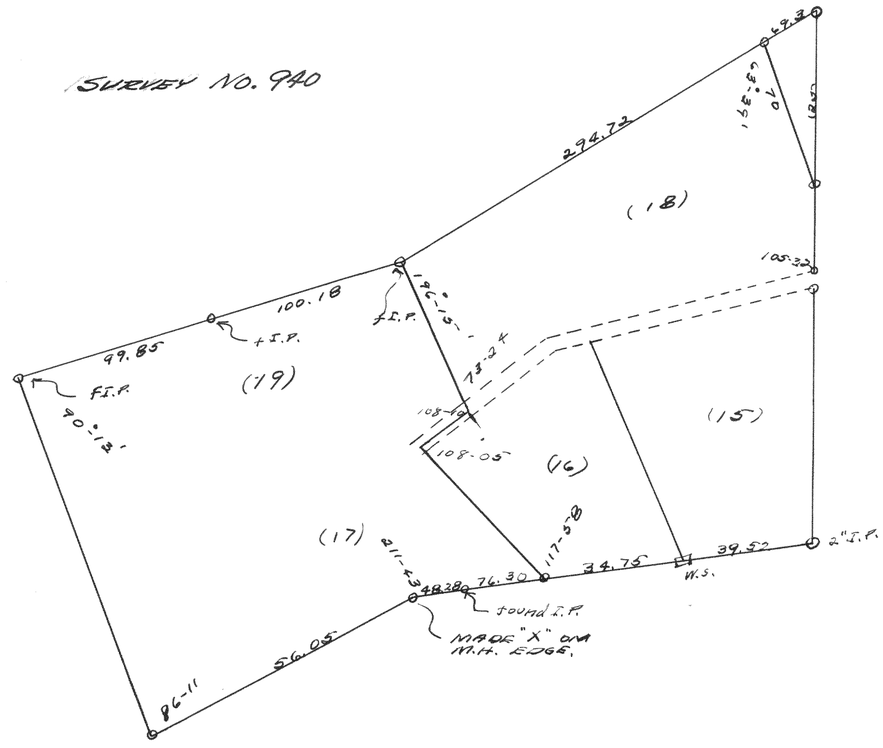

Survey of lots 17, 18, and 19 of Unit one of Country Club Estates.

4-21-38

Lloyd L. Jensen
by K.E.D.