

SURVEY No. 944

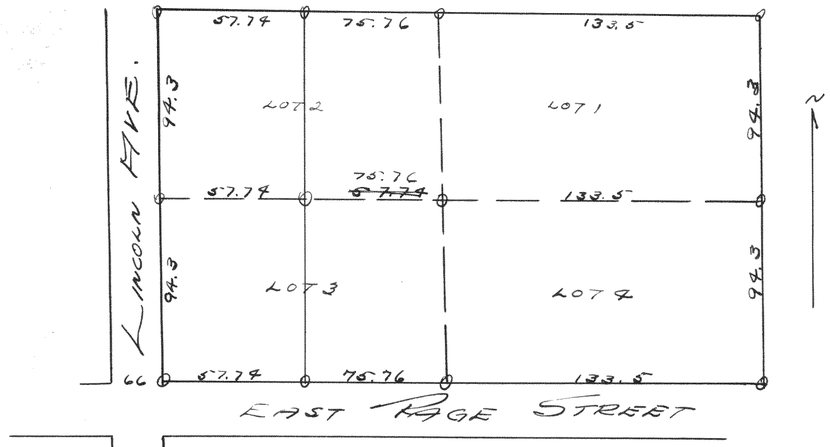

Survey of Block I of Rockwells addition to the city of Elkhorn
April 1937

Lloyd L Jensen
H. E. J.


SURVEY No. 945

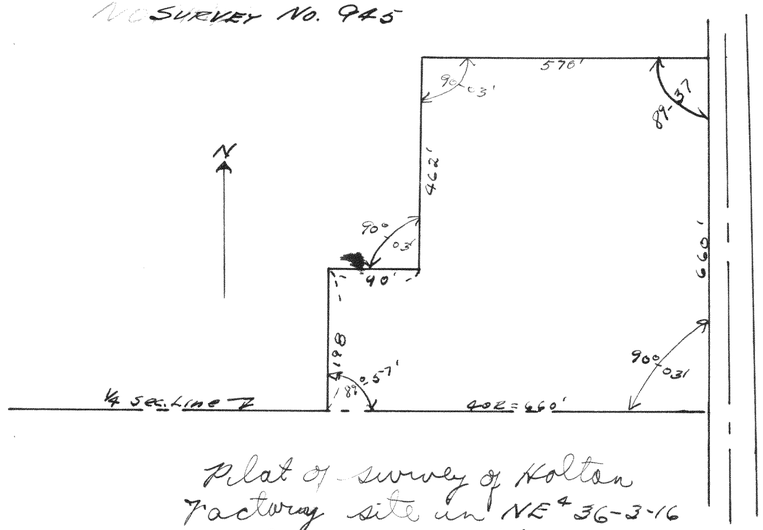

Plat of survey of Kolton factory site in NE¼ 36-3-16 in the city of Elkhorn
August 1938

Lloyd L. Jensen
by H. E. J.

SURVEY No. 946

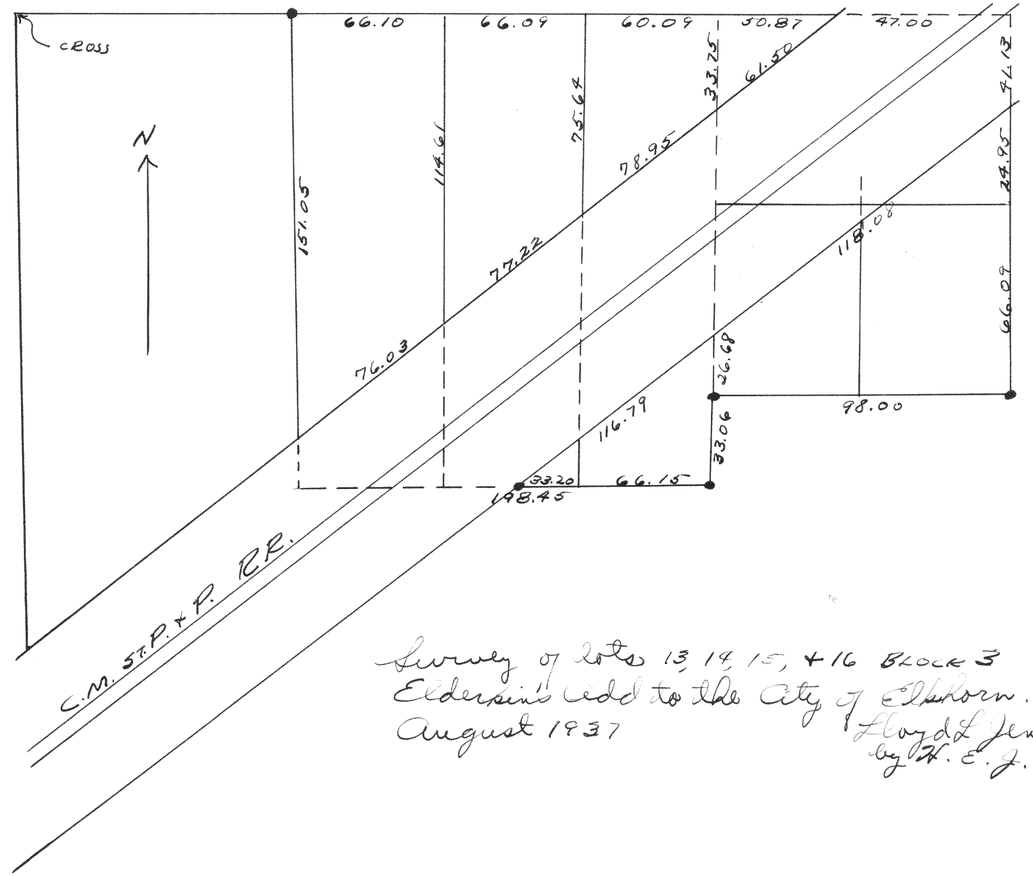

Survey of Lots 13, 14, 15, & 16 Block 3 Elderkin's add to the City of Elkhorn.
August 1937

Lloyd L Jensen
by H. E. J.