

312

SURVEY. NO. 947

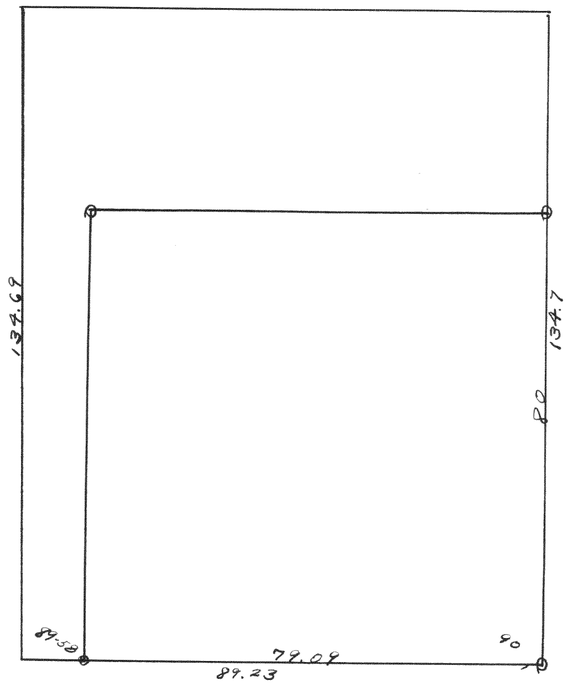

Survey of the East 78 feet of the South 80 feet of Lot 9 Blk. 16 of the original plat of Elkhorn.

SURVEY No. 948

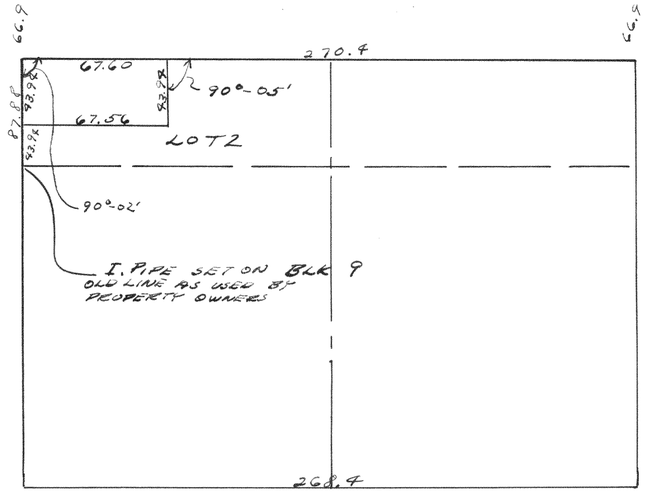


Survey of Northwest of Lot 2 of Blk. 9 of the original plat of the Village of Elkhorn

Nov. 24, 1937

Lloyd L Jensen
by W. C. J.

SURVEY No. 949

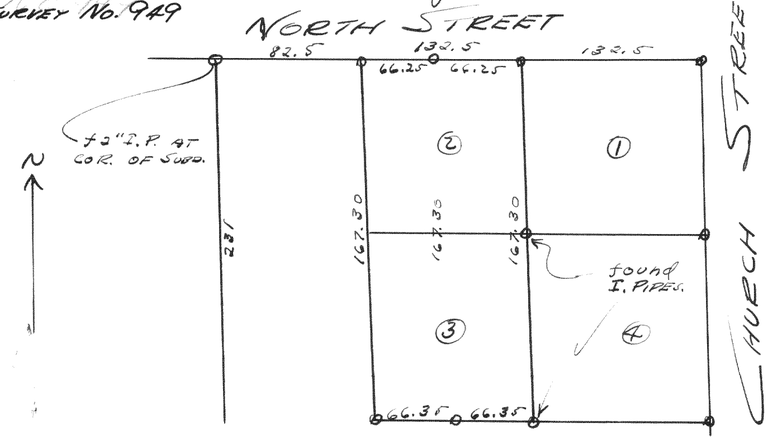

Survey of lots 2 & 3 of Blk 7 of the original Village of Elkhorn

10-4-37

Lloyd L Jensen
W. C. J.