
314

SURVEY No. 952

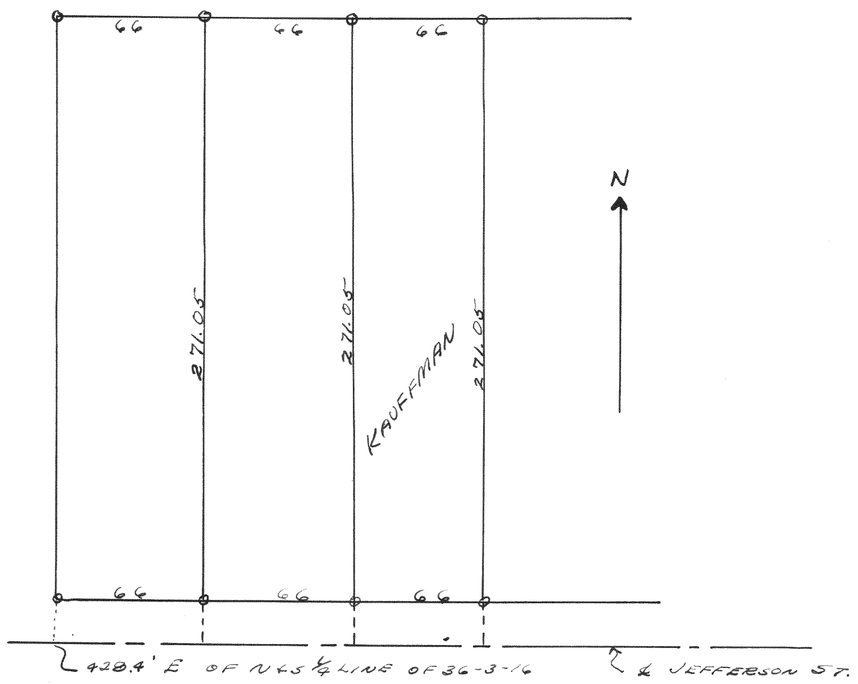


Survey for Clayton Kauffman in City of Elkhorn sec 36-3-16

April 19, 1938

Lloyd L. Jensen
by H.E.J.

SURVEY No. 953

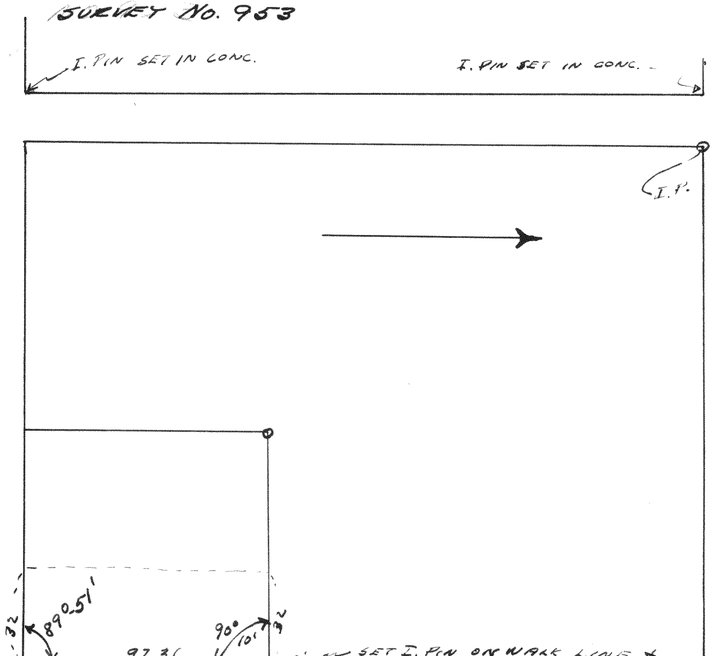

Survey of old post-office site in Block 20 of the original village of Elkhorn.

10-30-37

Lloyd L Jensen.