
Survey No. 960

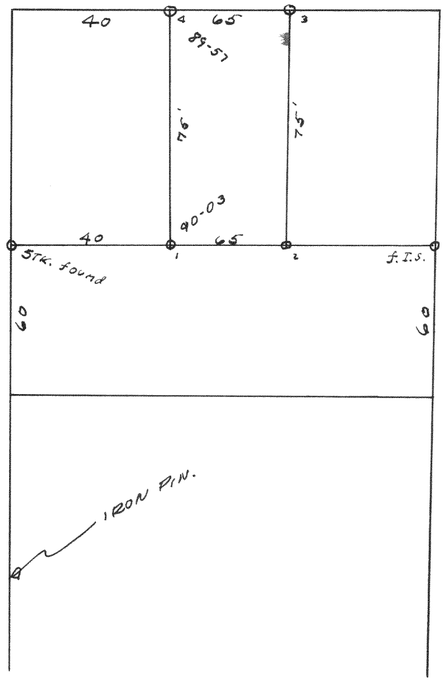


Survey of lot 2 Blk 22 of Chapman + Ludington's add.

4-23-37

Lloyd L. Jensen
by K. E. J.

Survey No. 961

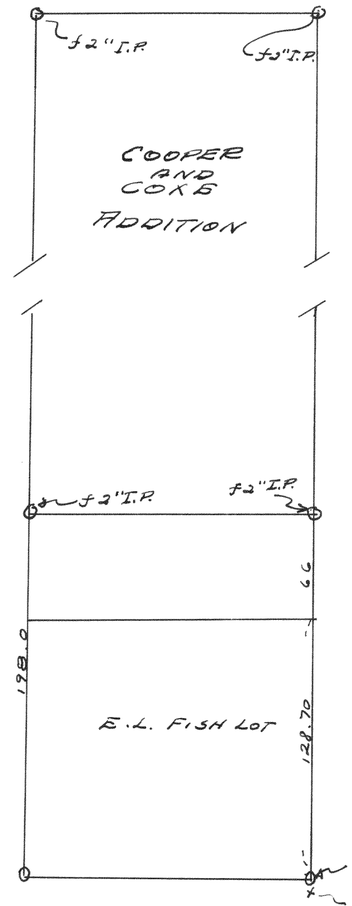


Survey of E. L. Fish lot in the City of Pinewater.

1938

Lloyd L. Jensen
by K. E. J.

Survey No. 962

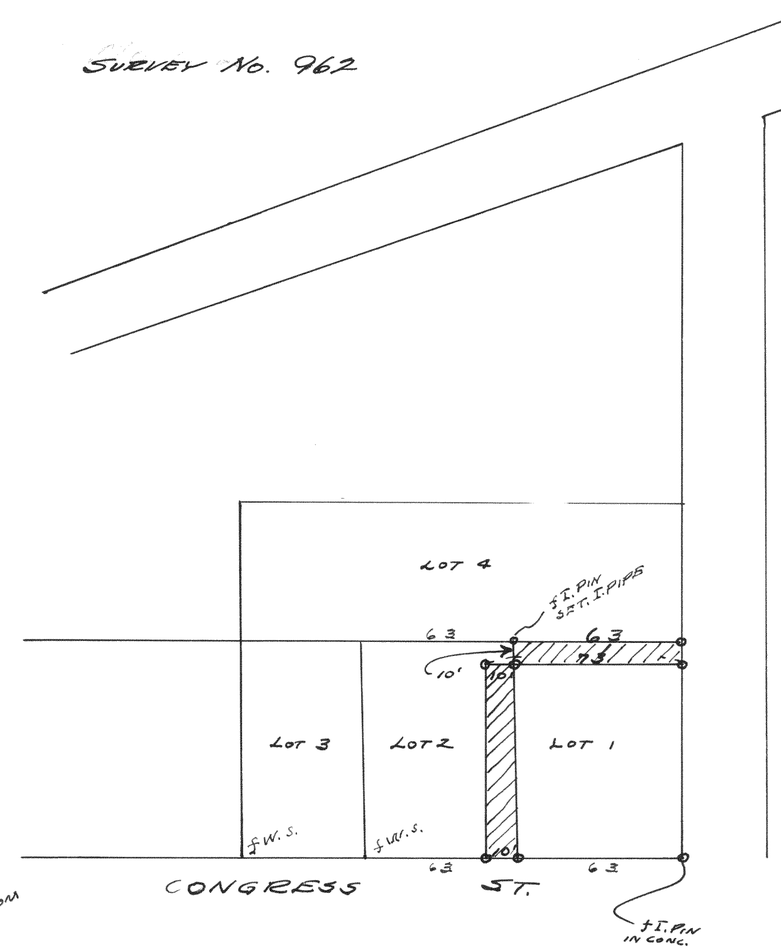

Survey of lots 1 and 2 of Madison Addition to Wms. Bay.

Nov. 7, 1938

Lloyd L. Jensen
by K. E. J.