
SURVEY No. 963

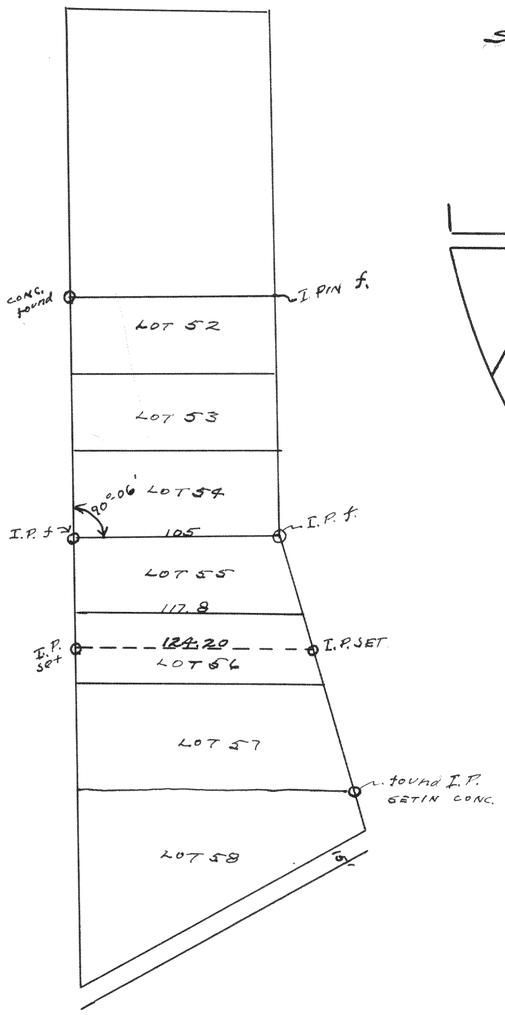


Survey of lot 55 and N½ lot 56 of the original plat of Cedar Point part.

7-37

Lloyd L. Jensen
by H. C. J.

SURVEY No. 964

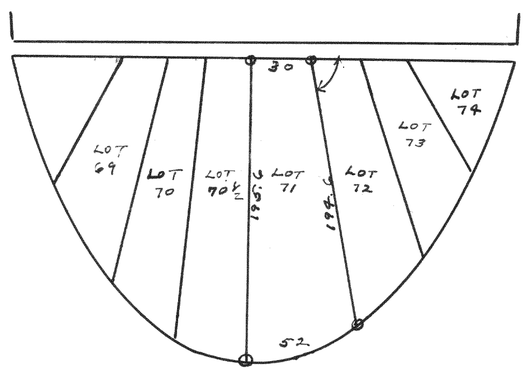


Survey of lot 71 of the first Addition to Cedar Point Park.

1938

Lloyd L. Jensen
by H. C. J.

SURVEY No. 965

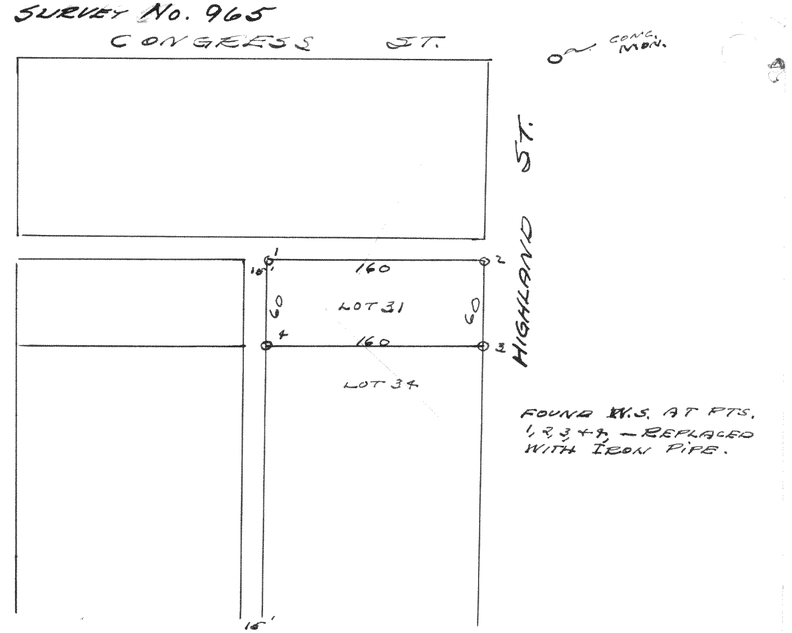

FOUND W.S. AT PTS. 1, 2, 3 + 4, — REPLACED WITH IRON PIPE.

Survey of lot 31 of Bay View Subdivision in the Village of Williams Bay.

3-23-38

Lloyd L. Jensen
by H. C. J.