Record of Survey


No. 83

Township ..... North of Range ..... of 4 Principal Meridian as presented by the courses and distances on the following plat, and annexed field-notes of survey:

Established the center of the section at the point of intersection of STRAIGHT quarter lines.

Established all quarter-quarter corners upon the section boundary at proportional distances between known section and quarter section corners, according to the original field-notes of the Government survey.

Established all lost corners at proportionate distances between known corners, according to the original field notes of the Government survey.

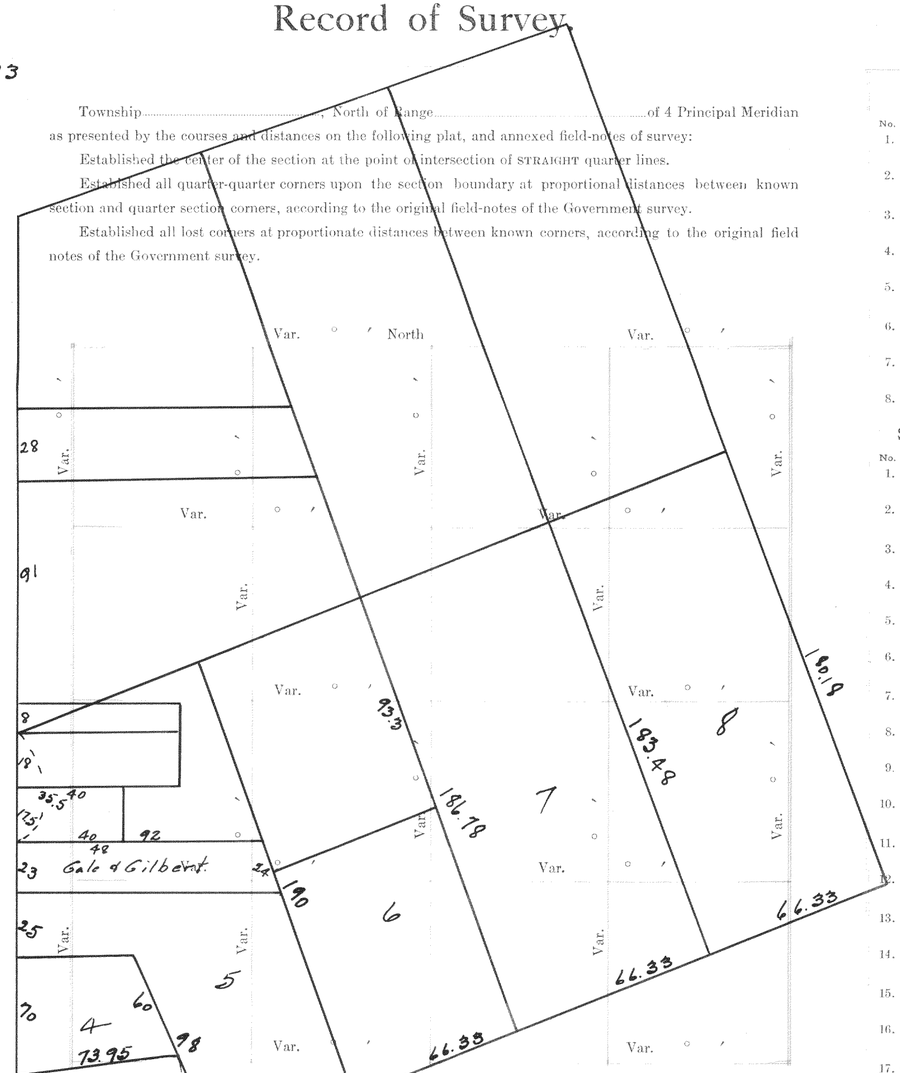

Plat of Section ..... , Township ..... North, Range ..... of 4 Principal Meridian Scale 80 chains to 6 inches. The figures in red ink are the lengths of the lines as stated in the field-notes of the Government survey.

Declination of the Magnetic Meridian from the True Meridian .....



Witness my hand this ..... day of ..... A. D. 1 .....

.....


DESCRIPTION

OF SECTION, QUARTER SECTION AND QUARTER QUARTER SECTION CORNERS

H. C. MILLEN CO. MFG. STATIONERS, MILWAUKEE X15000

GOVERNMENT CORNERS	Bearing Trees	In. Dia.	Courses they bear	Links Distant	Bearing Trees	In. Dia.	Courses they bear	Links Distant	Bearing Trees	In. Dia.	Courses they bear	Links Distant	Bearing Trees	In. Dia.	Courses they bear	Links Distant
No.																
1. N. W. Sec. Cor. indentified,																
2. N. E. Sec. Cor. indentified,																
3. S. E. Sec. Cor. indentified,																
4. S. W. Sec. Cor. indentified,																
5. N. ¼ Sec. Cor. indentified,																
6. E. ¼ Sec. Cor. indentified,																
7. S. ¼ Sec. Cor. indentified,																
8. W. ¼ Sec. Cor. indentified,																
Subdivision Corners																
No.																
1. Center ¼ Sec. Cor.																
2. North ¼-¼s N. W. qr.,																
3. East ¼-¼s N. W. qr.,																
4. South ¼-¼s N. W. qr.,																
5. West ¼-¼s N. W. qr.,																
6. Center ¼-¼s N. W. qr.,																
7. North ¼-¼s N. E. qr.,																
8. East ¼-¼s N. E. qr.,																
9. South ¼-¼s N. E. qr.,																
10. Center ¼-¼s N. E. qr.,																
11. East ¼-¼s S. E. qr.,																
12. South ¼-¼s S. E. qr.,																
13. West ¼-¼s S. E. qr.,																
14. Center ¼-¼s S. E. qr.,																
15. South ¼-¼s S. W. qr.,																
16. West ¼-¼s S. W. qr.,																
17. Center ¼-¼s S. W. qr.																

No. 84

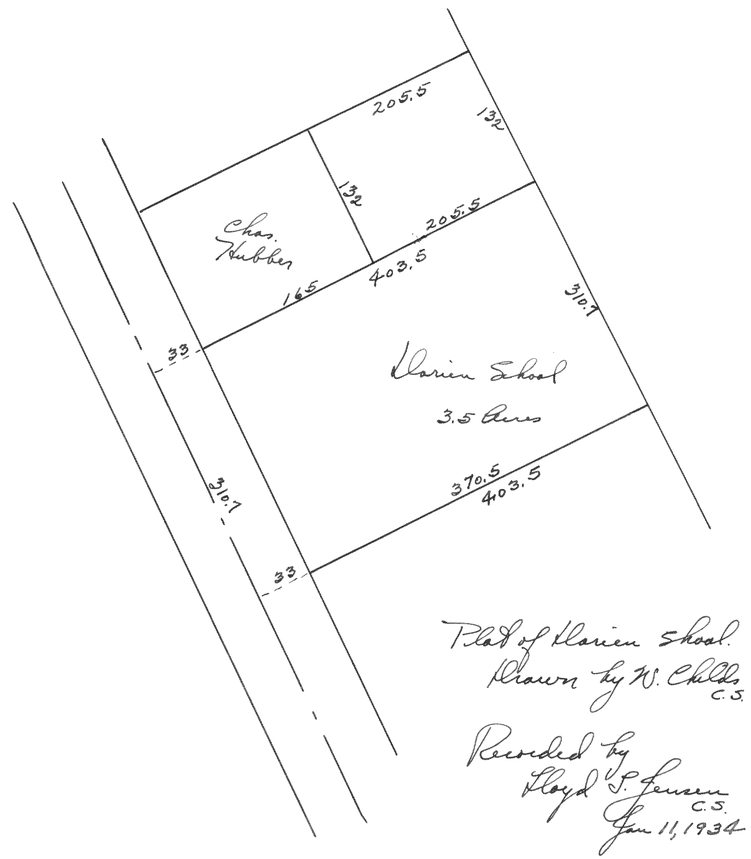

Drawn by W. Childs C.S.

Recorded by
Lloyd S. Jensen
C.S.
Jan 11, 1934

NAMES OF SWORN ASSISTANTS

CHAINMEN	FLAGMEN	AXMEN

No. 85



Plat of Blk. 8 of the orginal town of Darien.

Drawn by William Child C.S.

Recorded by Lloyd S. Jensen C.S. Jan. 19, 1934

No. 86

Survey of the Roy Thomas farm as shown in the 1930 Atlas.

This is to certify

That I did on the 23rd. day of April 1921, make a survey on the East half, of the north West Quarter, of Section No. 9 and the South East Quarter of the S.W. quarter of Section No. 4 of Town No 2 North, Range 15 East, being the farm of Darien, Walworth County, Wisconsin, as follows to wit:-

In making this survey the fences were taken as the lines and the measurements made were to them these from.

On the one eighth Section line, a point was made 30 feet North of the fence post on the South side of the road, for the center of the road, and from this point north 1952 feet to the N. W. corner of the said East half. Then East 1328 feet, to the quarter Section corner, on the North side of said section, being the North East corner of the said East half. Thence South, along the said East line, being also the N. & S. 1/4 line, 1952 feet to a pt, that is 1325 feet East of the place of beginning, and 639 feet more to a point 38' South of the fence post on the North side of the road, which point was taken as the center of the road, and being 47' North of the South East corner of the said West half, and I find that this piece contains 69.16 Acres.

And also from the S. W. corner of the said S.E. 1/4 of the S.W. 1/4, North 1332 feet to the corner as fenced. Then East 1327 feet to the corner as fenced. Then South 1329 feet to the corner, and find that South of a line 660 feet, equalling 40 rods South of the North line, that piece contains 20.43 Acres, as a Total of 89.59 Acres.

Surveyed by William Childs C.S.

Recorded by Lloyd S. Jensen C.S. Jan. 19, 1934