


Survey of Lot 7 & dividing vacant lot just North of Lot 7 - of Loughwood Park.

6-22-38

Lloyd L Jensen
C.E.

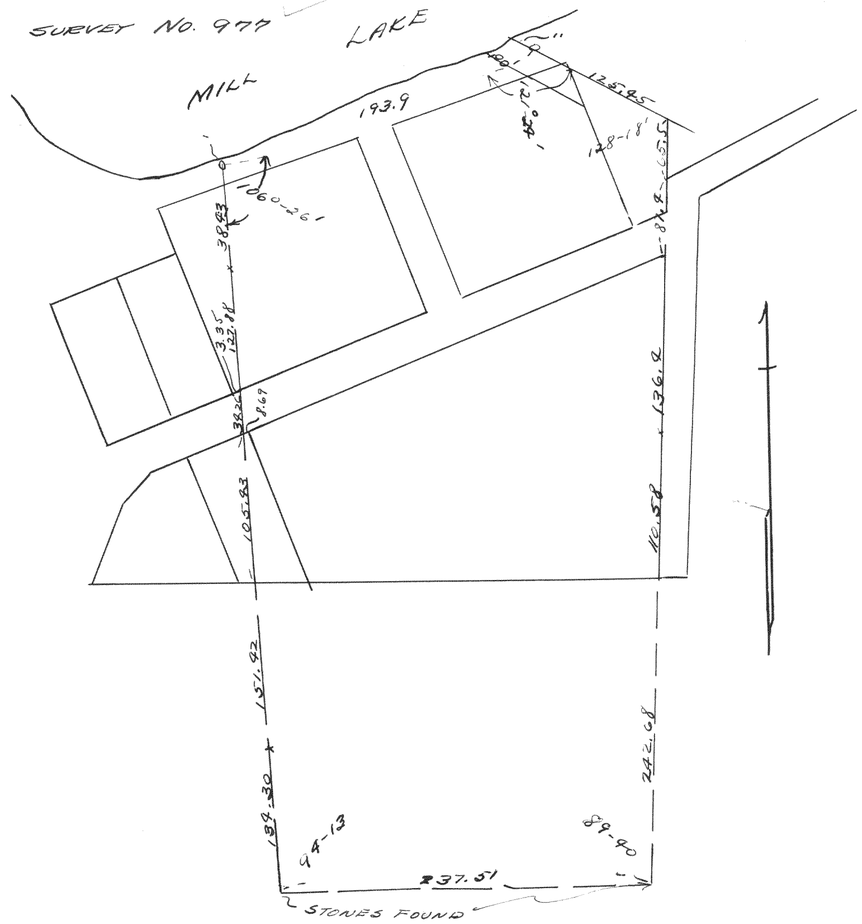

Plat of Survey of Lauderdale Heights & adjoining land.

July 1938

Lloyd L Jensen
C.E.