
SURVEY No. 978

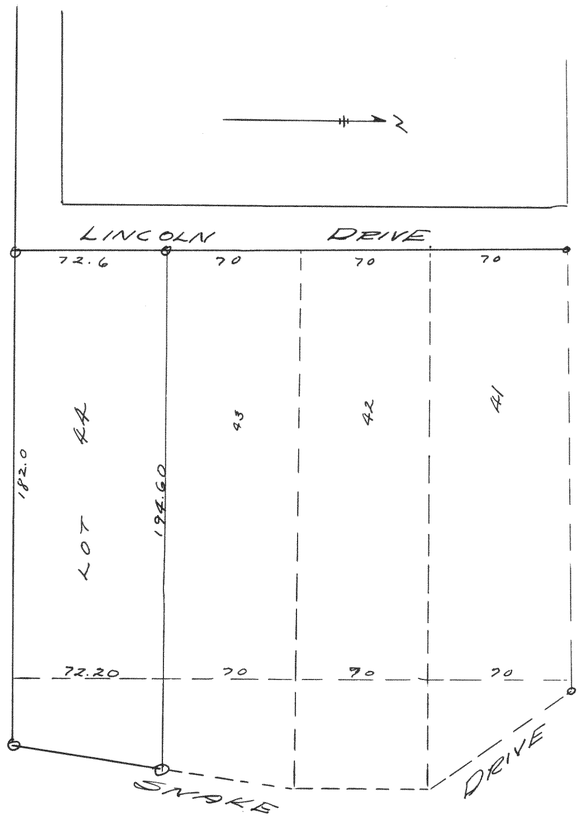


Plat of survey of Lot 44 of Lackey Bros. Subdivision in the Village of Wms. Bay.

June, 1939

Lloyd L. Jensen
by W.C.J.

SURVEY No. 979

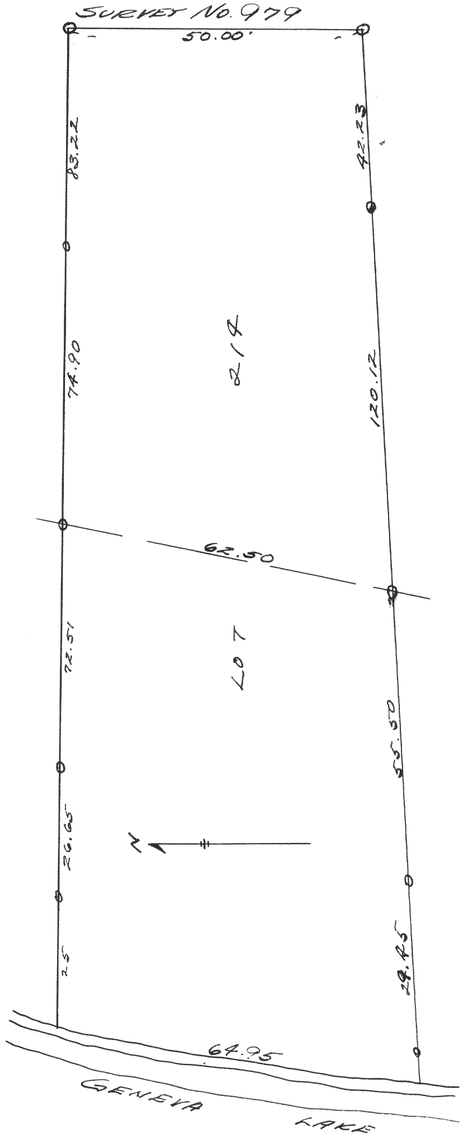


Plat of survey of lot 214 of the 3RD add to Cedar Point Park, in the Village of Wms. Bay.

June, 1939

Lloyd L. Jensen
by W.C.J.

SURVEY No. 980

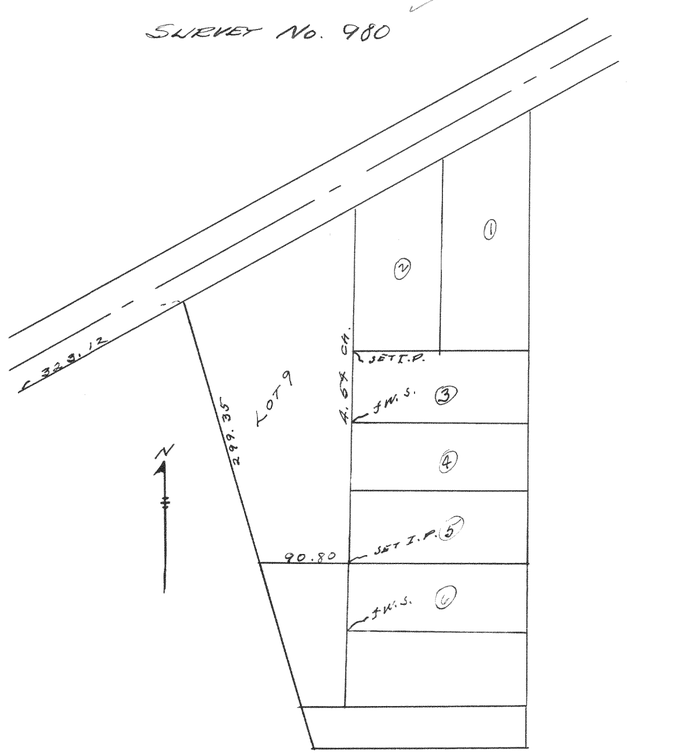

Plat of survey of that part of lot 9 which lies North of the North line of lot 6 extended. All in Caines Add. to the City of Whitewater

April 1939

Lloyd L. Jensen
by W.C.J.