
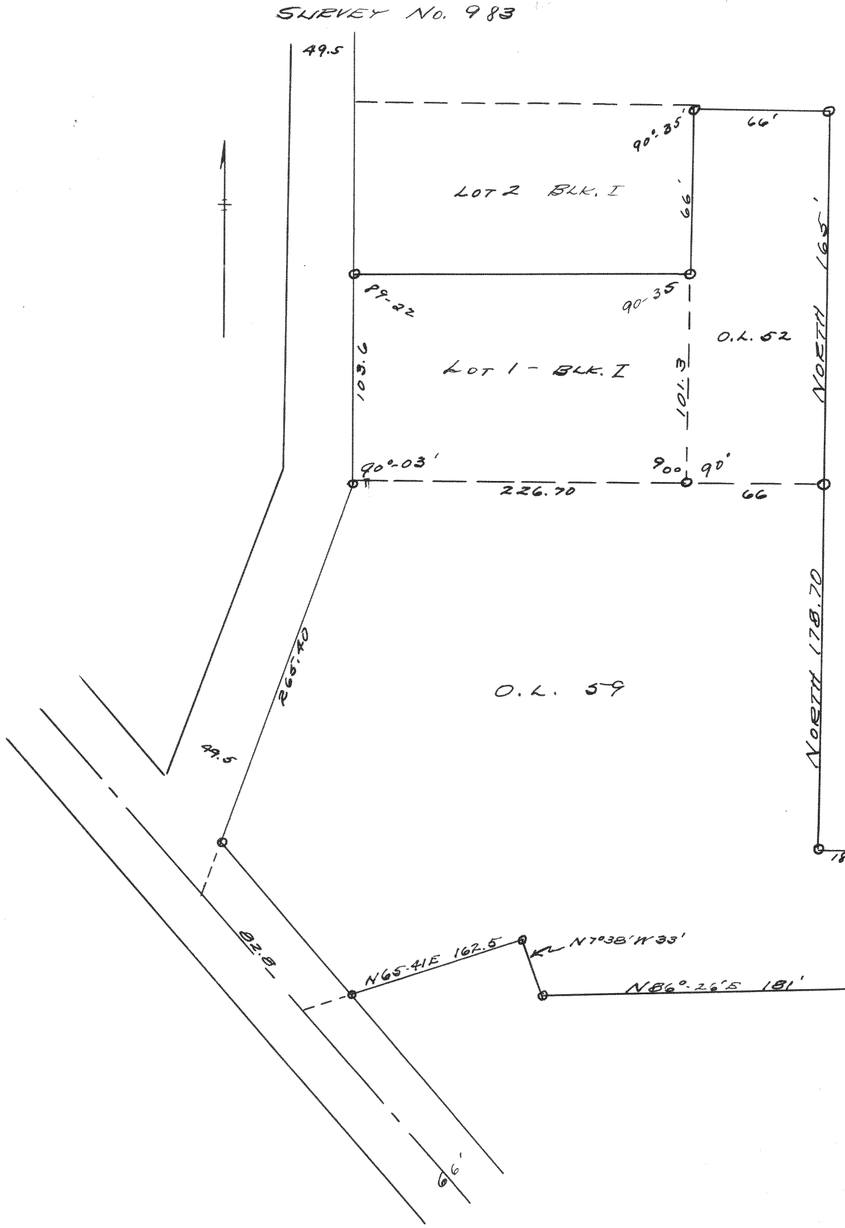



Plat of survey of outlots 52 & 59 and Lot I Block I of Crandall & Swinney's add. to the Village of Walworth
December 5, 1938

Lloyd L. Jensen
by H.E.J.

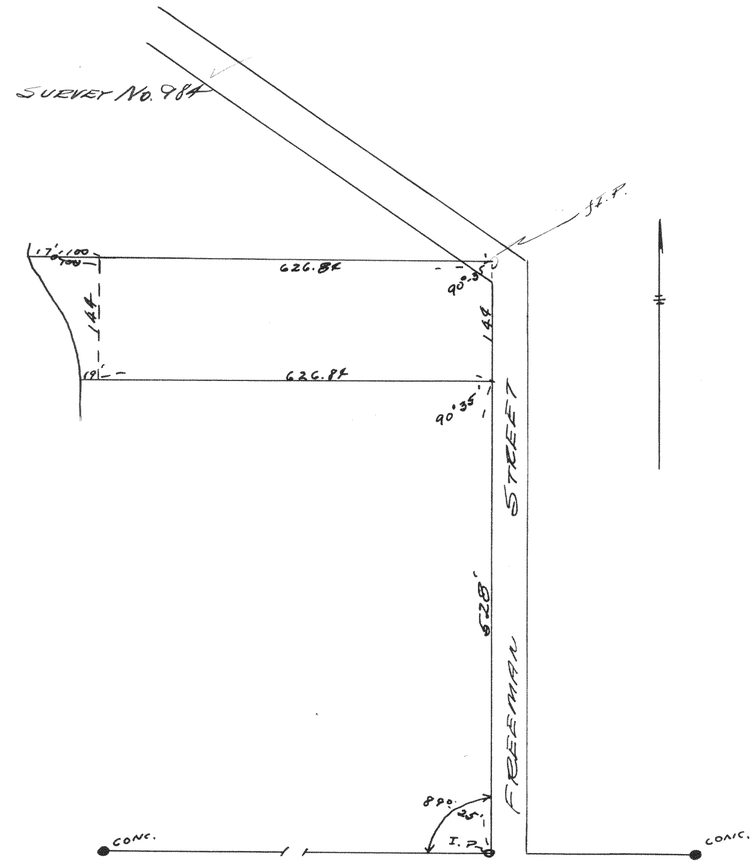


Plat of survey of part of NE¼ of Sec 35 T 1N R 15E, in the Village of Genoa City.
May 1939

Lloyd L Jensen
by H.E.J.