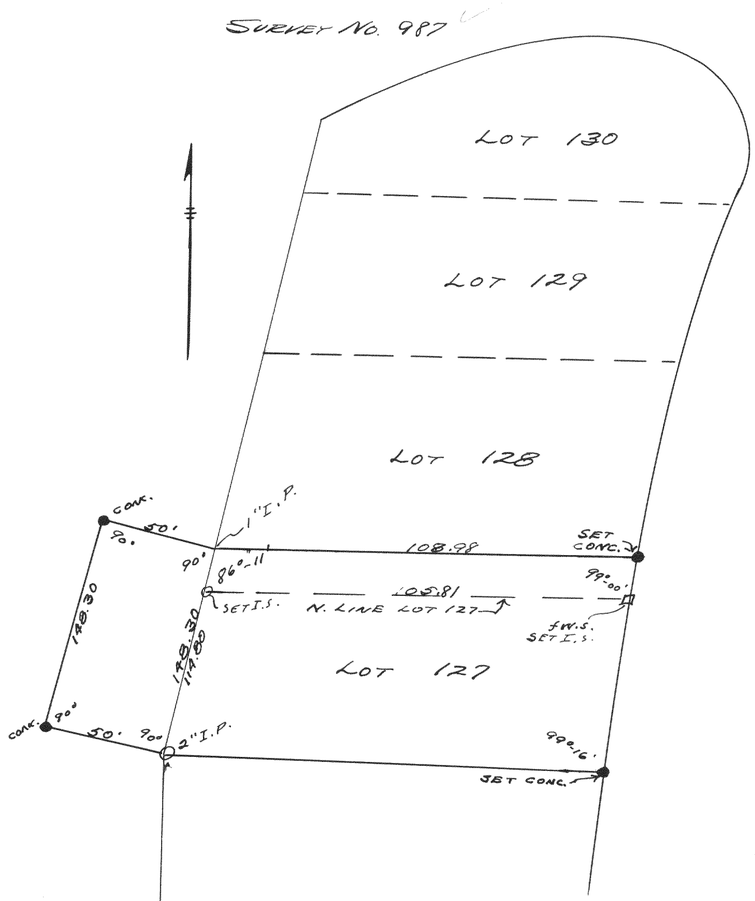

Plat of survey of lot 127, the South ½ of lot 128, and a parcel by metes & bounds adjoining said lots. County Club Estates, Fontana.
April, 1939
Lloyd L. Jensen
by K.E.J.

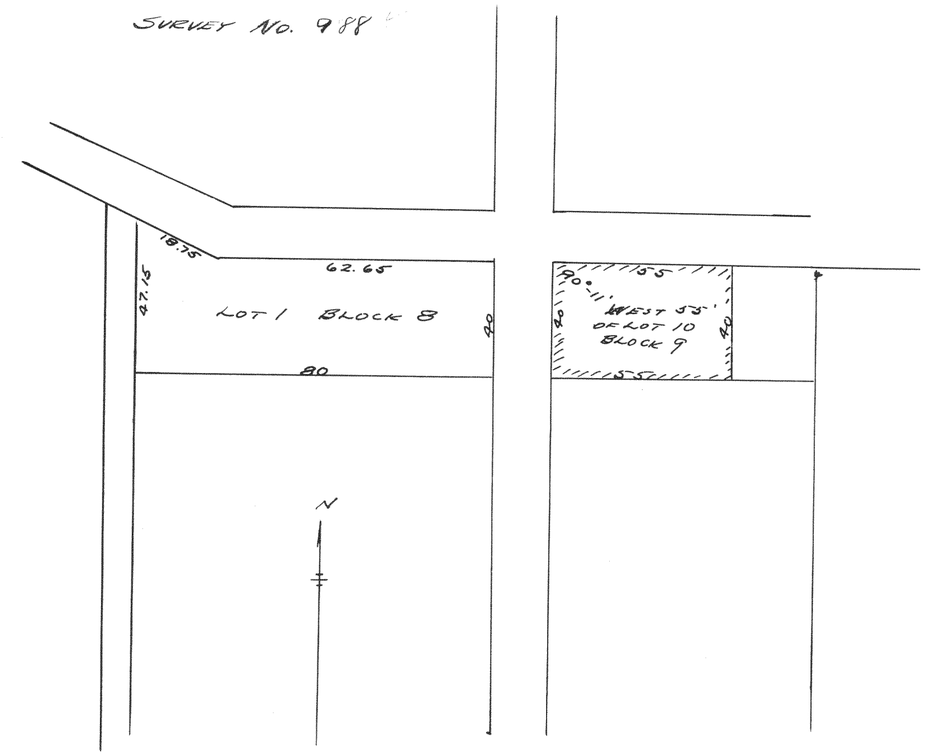

Plat of survey of Lot 1 Block 8 and the West 55 feet of Lot 10 Blk. 9 of Glenwood Springs, in the Village of Fontana, Walworth County, Wis.
April 10, 1939
Lloyd L. Jensen
by K.E.J.