
SURVEY No. 989

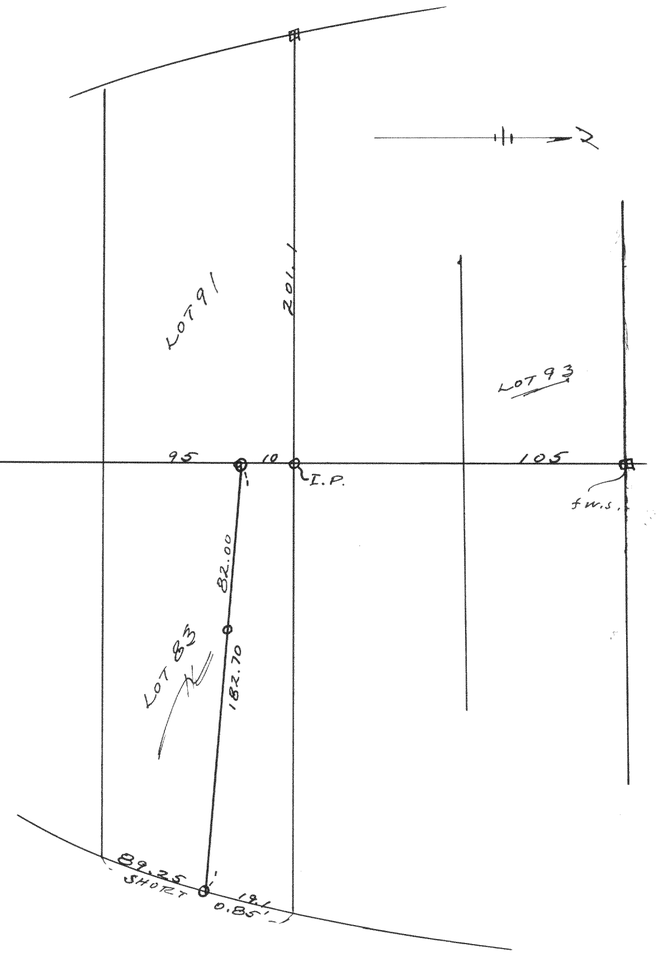


Plat of survey of part of Lot 83 of Unit 2 of Country Club Estates, Delavan Wisconsin.

April, 1939

Lloyd L. Jensen
by W. E. J.

SURVEY No. 990

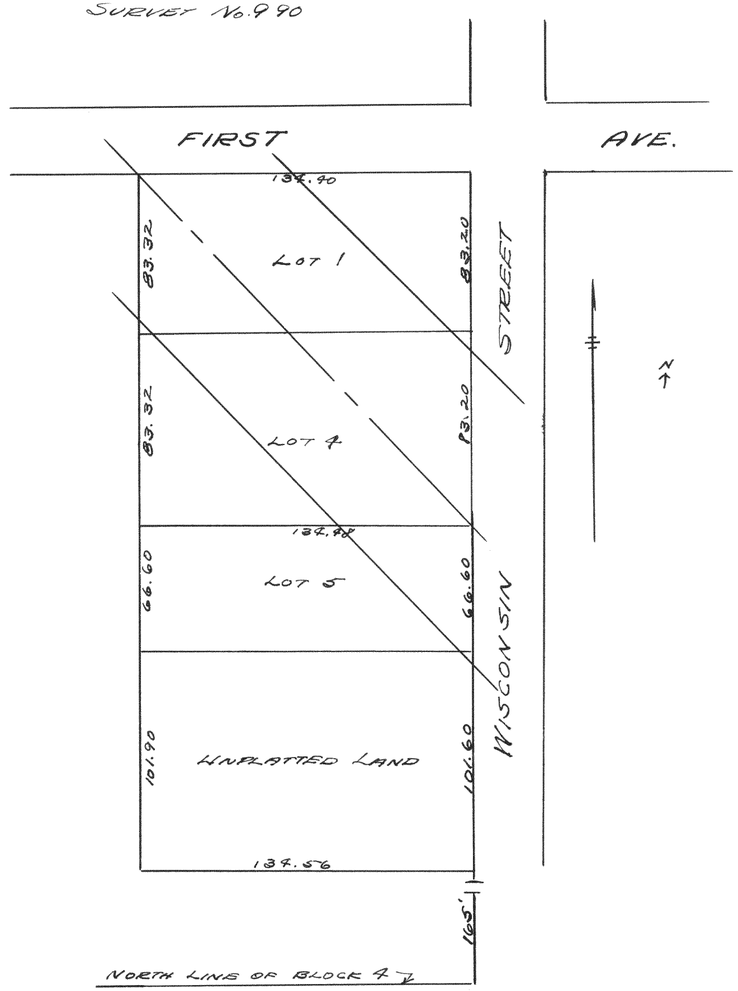

Plat of survey of Lots 1, 4 & 5 - Blk 37 of Davis' add. and adjoining unplatted land all in the City of Elkhorn, Walworth County, Wisconsin.

June 12, 1939

Lloyd L. Jensen
by W. E. J.