
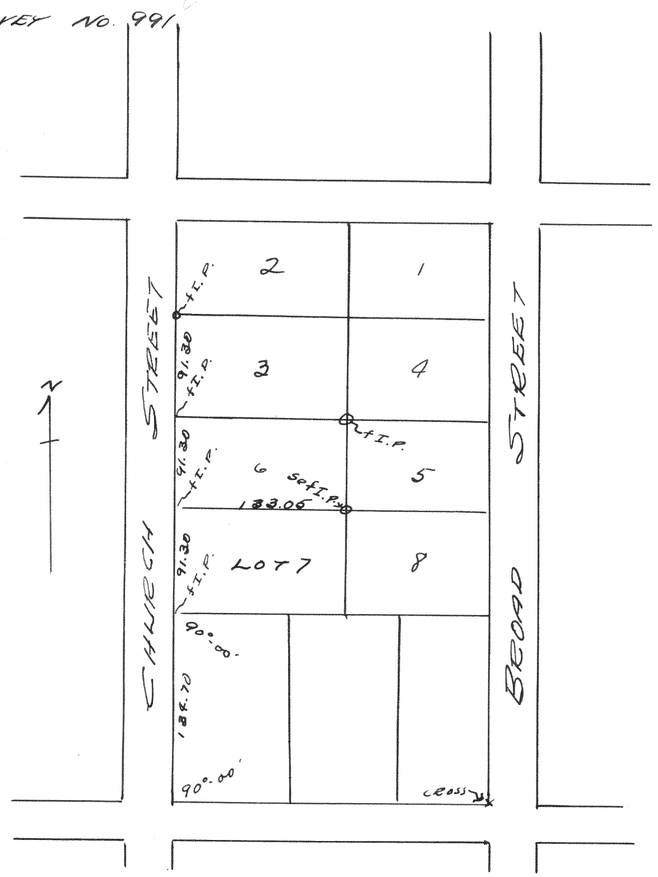


Plat of survey of Lot 7 Block 17 of the original plat of the City of Elkhorn.

9-16-38

Lloyd L. Jensen
by H.C.J.

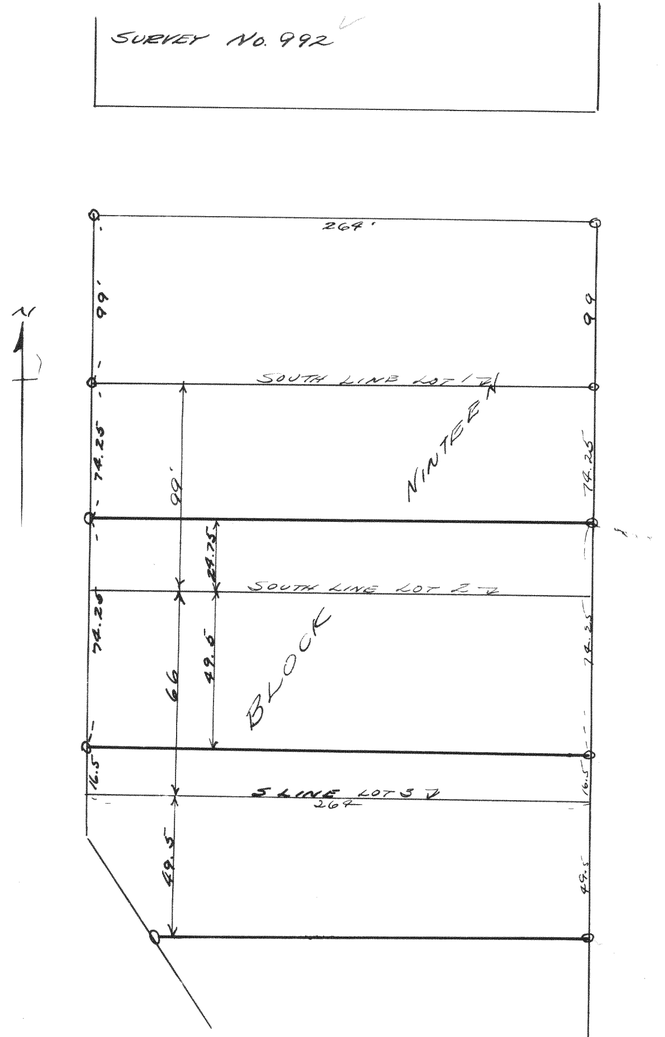

Plat of survey of lots 2 & 3 of Block 19 of the original village of East Troy,

April 3, 1939

Lloyd L. Jensen
By H.C.J.