

332

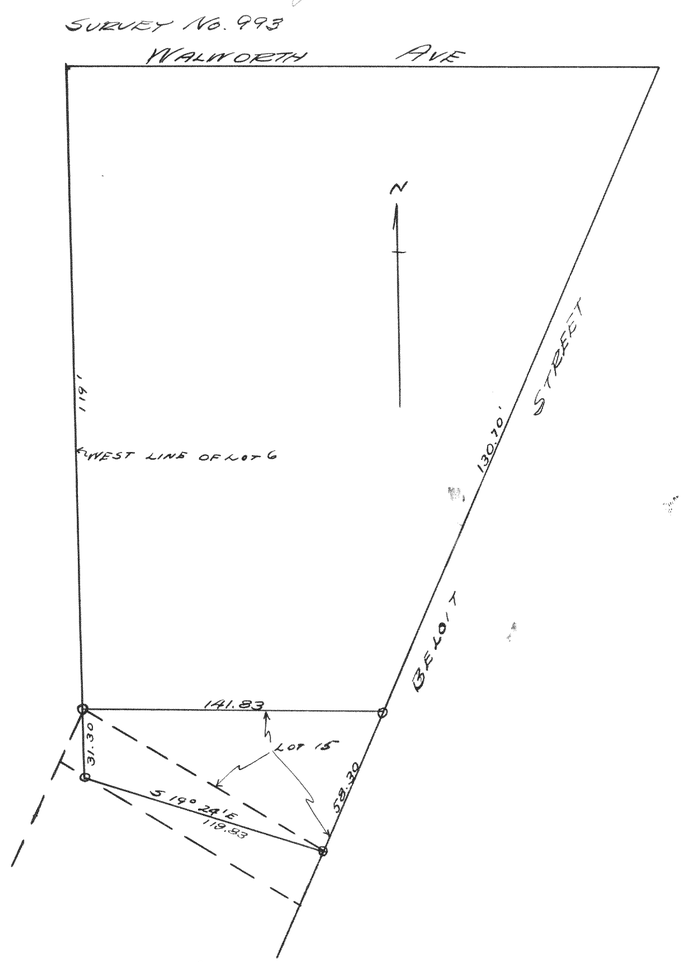

Plat of survey of part of Block 2 of F K. Rhoenix West Addition to the city of Delavan
Mar. 16, 1939

Lloyd L Jensen
by H. E. J.

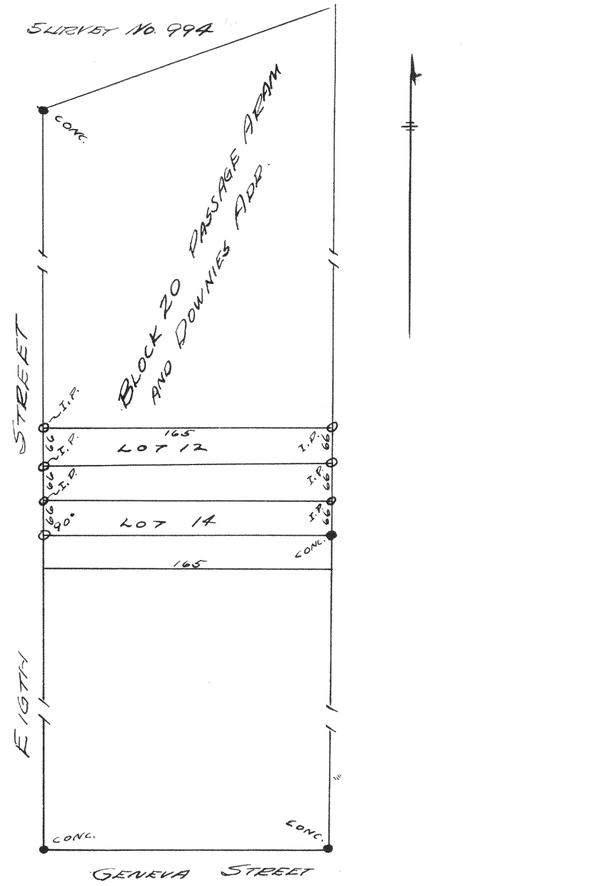

Plat of survey of lots 12 & 14 block 20 of Passage and Aram & Downies Add. to the City of Delavan
May 1939

Lloyd L. Jensen
by H. E. J.