

SURVEY No. 1006

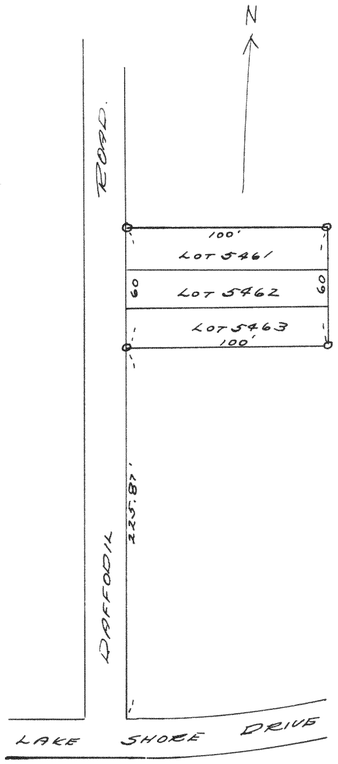


Plat of survey of lots 5461 to 5463 of Lake Como Beach Subd. Wal. Co. Wis.
July 8, 1939
Lloyd L. Jensen
by W. E. J.

SURVEY No. 1007

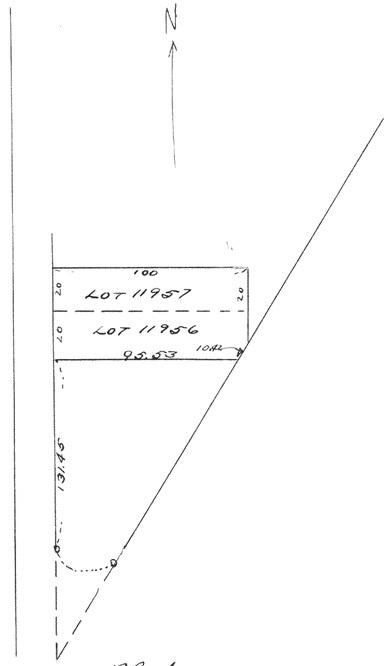

Plat of survey of lots 11956 to 11957 of Lake Como Beach Subd.
July 7, 1939
Lloyd L. Jensen
by W. E. J.

SURVEY No. 1008

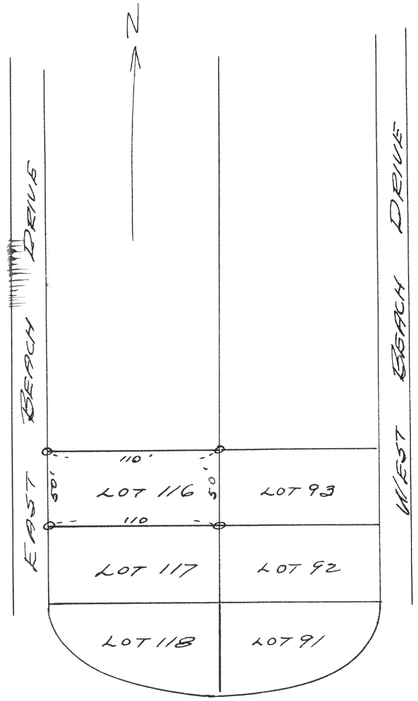

Plat of survey of lot 116 of Lake Geneva Beach Walworth County Wisc.
July 1939
Lloyd L. Jensen
by W. E. J.