

SURVEY NO. 1009 ~~1006~~

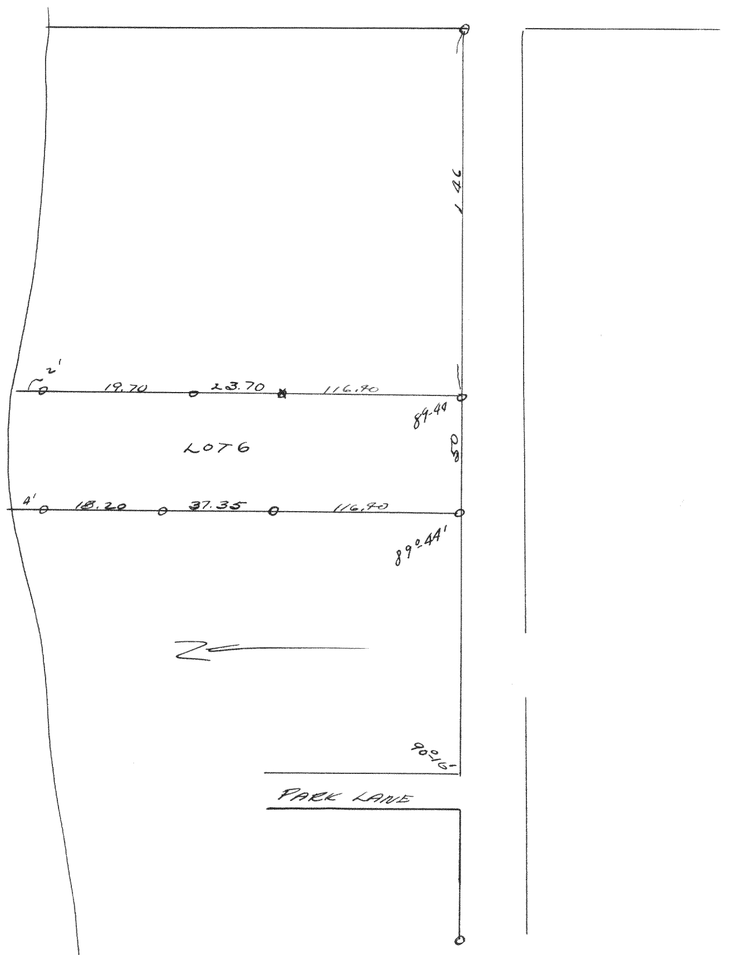

Plat of survey of dot 6 of Edgewater Terrace, Walworth County Wisconsin (1-17)
July, 1939 Lloyd L. Jensen by H.E.J.

SURVEY NO. 1010 ~~1007~~

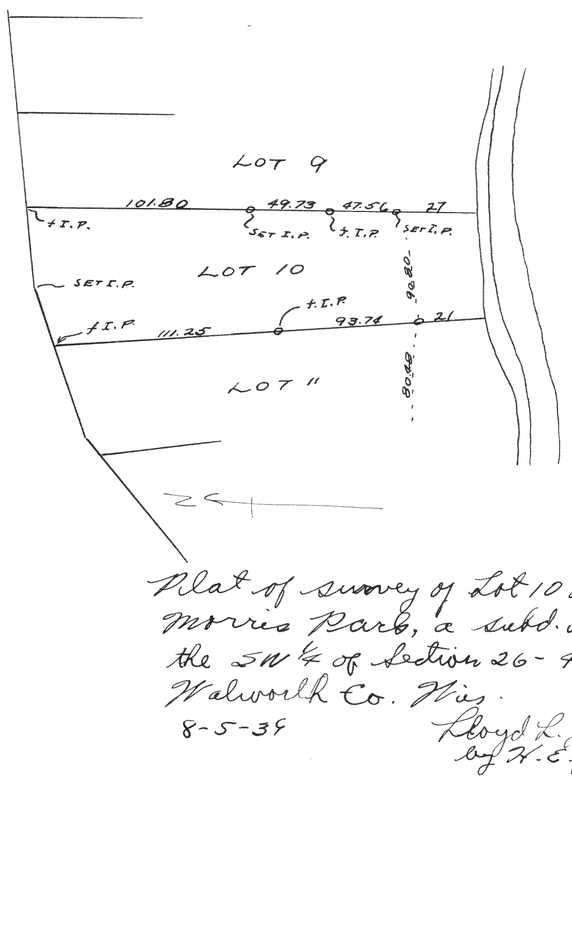

Plat of survey of Lot 10 of Morris Park, a subd. in the SW ¼ of Section 26-4-16 Walworth Co. Wis.
8-5-39 Lloyd L. Jensen by H.E.J.