Record of Survey.

No. 91

Blk. 9 of Marion


Township ..., North of Range ... of 4 Principal Meridian as presented by the courses and distances on the following plat, and annexed field-notes of survey:

Established the center of the section at the point of intersection of STRAIGHT quarter lines.

Established all quarter-quarter corners upon the section boundary at proportional distances between known section and quarter section corners, according to the original field-notes of the Government survey.

Established all lost corners at proportionate distances between known corners, according to the original field notes of the Government survey.

At N. W. cor of Blk 8 found iron stake, from this ran NE and found stake hole at NW of Blk 9 and at NE of lot 4, Blk 9. Found three in line, from NW cor. of Blk, SE 82.5 feet found stake hole, set stake in three points and from last stake, NE 132.1 found stake hole 82.5 SE. of NE of lot 4. Drove stake and from SE and SW corners set back 20.00' to offset stakes for north line of S 1/4 of lot 4.

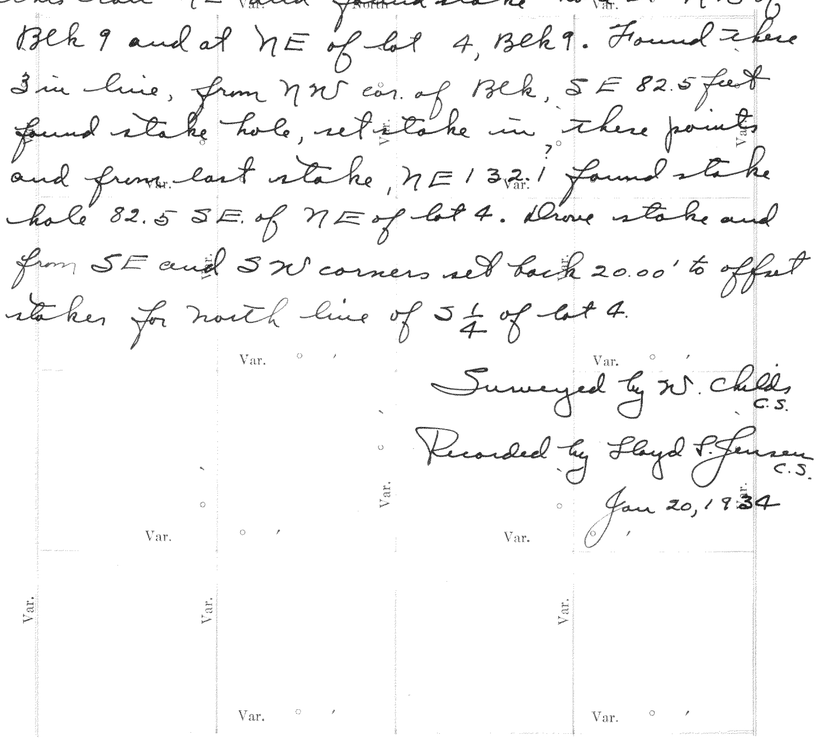

Surveyed by W. Childs C.S.

Recorded by Floyd S. Jensen C.S.

Jan 20, 1934

Plat of Section ..., Township ... North, Range ... of 4 Principal Meridian Scale 80 chains to 6 inches. The figures in red ink are the lengths of the lines as stated in the field-notes of the Government survey.

Declination of the Magnetic Meridian from the True Meridian ...

Surveyed and sub-divided ... A. D. 1 , in accordance with the State Laws and Instructions of the Commissioner of the General Land office, and recorded on pages ... of Register in the County Clerk's office.

Witness my hand this ... day of ... A. D. 1

... SURVEYOR.

DESCRIPTION

OF SECTION, QUARTER SECTION AND QUARTER QUARTER SECTION CORNERS

H. C. MILLER CO., MFG. STATIONERS, MILWAUKEE X15000

GOVERNMENT CORNERS	Bearing Trees	In. Dia.	Courses they bear	Links Distant	Bearing Trees	In. Dia.	Courses they bear	Links Distant	Bearing Trees	In. Dia.	Courses they bear	Links Distant	Bearing Trees	In. Dia.	Courses they bear	Links Distant
No.																
1. N. W. Sec. Cor. indentified,																
2. N. E. Sec. Cor. indentified,																
3. S. E. Sec. Cor. indentified,																
4. S. W. Sec. Cor. indentified,																
5. N. 1/4 Sec. Cor. indentified,																
6. E. 1/4 Sec. Cor. indentified,																
7. S. 1/4 Sec. Cor. indentified,																
8. W. 1/4 Sec. Cor. indentified,																
Subdivision Corners																
No.																
1. Center 1/4 Sec. Cor.																
2. North 1/4-1/4s N. W. qr.,																
3. East 1/4-1/4s N. W. qr.,																
4. South 1/4-1/4s N. W. qr.,																
5. West 1/4-1/4s N. W. qr.,																
6. Center 1/4-1/4s N. W. qr.,																
7. North 1/4-1/4s N. E. qr.,																
8. East 1/4-1/4s N. E. qr.,																
9. South 1/4-1/4s N. E. qr.,																
10. Center 1/4-1/4s N. E. qr.,																
11. East 1/4-1/4s S. E. qr.,																
12. South 1/4-1/4s S. E. qr.,																
13. West 1/4-1/4s S. E. qr.,																
14. Center 1/4-1/4s S. E. qr.,																
15. South 1/4-1/4s S. W. qr.,																
16. West 1/4-1/4s S. W. qr.,																
17. Center 1/4-1/4s S. W. qr.																

No. 92

C. L. Van Swearingen

12-2-15

At N. E. corner take center of fence running north for beginning, Road 60 feet wide, West 680 fence, 1309 fence South and 1318 fence North, 2644 corner, South x 1057 set flag and 1836 NW. corner of Long piece. East 1310.7 find small stake in line of fence and 62.5 South find stake, North along fence 264 fence post and 1621 more end of fence running North. East from post 660 to end of fence running South, North 564 fence post, East 636 North end of fence South, Road 49.5, making 660.75 or (660.5) to center. This post is 2 South of line of fence W. North from line of fence 1057.

Surveyed by William Childs C.S.

March 19, 1915

Recorded by Floyd S. Jensen C.S.

Jan 20, 1934

NAMES OF SWORN ASSISTANTS

CHAINMEN	FLAGMEN	AXMEN

~~No. 34~~

No. 93 27-2-15

At South East corner found stake and stones, drove new stake, Ran West, at 20.12½ found stake set by former survey. Could not find gr. post but set same at 40.25 and in line of corner and ⅛ post. At N. W. corner make pt. by posts. Ran S 39.98 find slight evidence of stake. Set new stake being about in Center of Road and in line of fence South. South from this stake at 22.89 center of R.R. track in line of fence South. At 37.98 N. side of road. At S.W. cor. find slight evidence of stake and set stake in place. This being 39.97 South of gr. post and 2 links E. of line from NW cor. over gr. post, also 40.27 W. of S gr. post and 2 lks. N. of line from SE. cor. over S ¼ post, from NW. cor. E. at 40.11 center of road as fenced, 80.36 point between posts attested to as corner. From this point S. at 23.70 center of R.R. 31.19 nail in post on N. of road.

Ran random line on W. at NW. corner this is 45 W., at gr. post 26½ W, 49 N at S W. corner.
From this line turned angle in center of track N & E. 65°-39' and ran E, from this line at 27.80 center of C & M. road and beginning of curve, at 32.41 angle, 5.5' S. of center, angle is 3°-30' and at 400' tangent

Surveyed by William Childs C.S.
July 27 & 28, 1911
Recorded by Floyd S. Jensen C.S.
Jan 20, 1934

No. 94

Lindman and Humphrey
L 3, Blk 8

Found iron stake at S W. corner of lot 3 also at N W. cor. of Blk, on this line made pts at 8', then 24'-9", then 34 to center of wall, then 32 and 24 more.

Ran back at right angles to Street from these to back of lot.

Surveyed by William Childs C.S.

Recorded by Floyd S. Jensen C.S.
Jan 20, 1934