

SURVEY NO. 1017

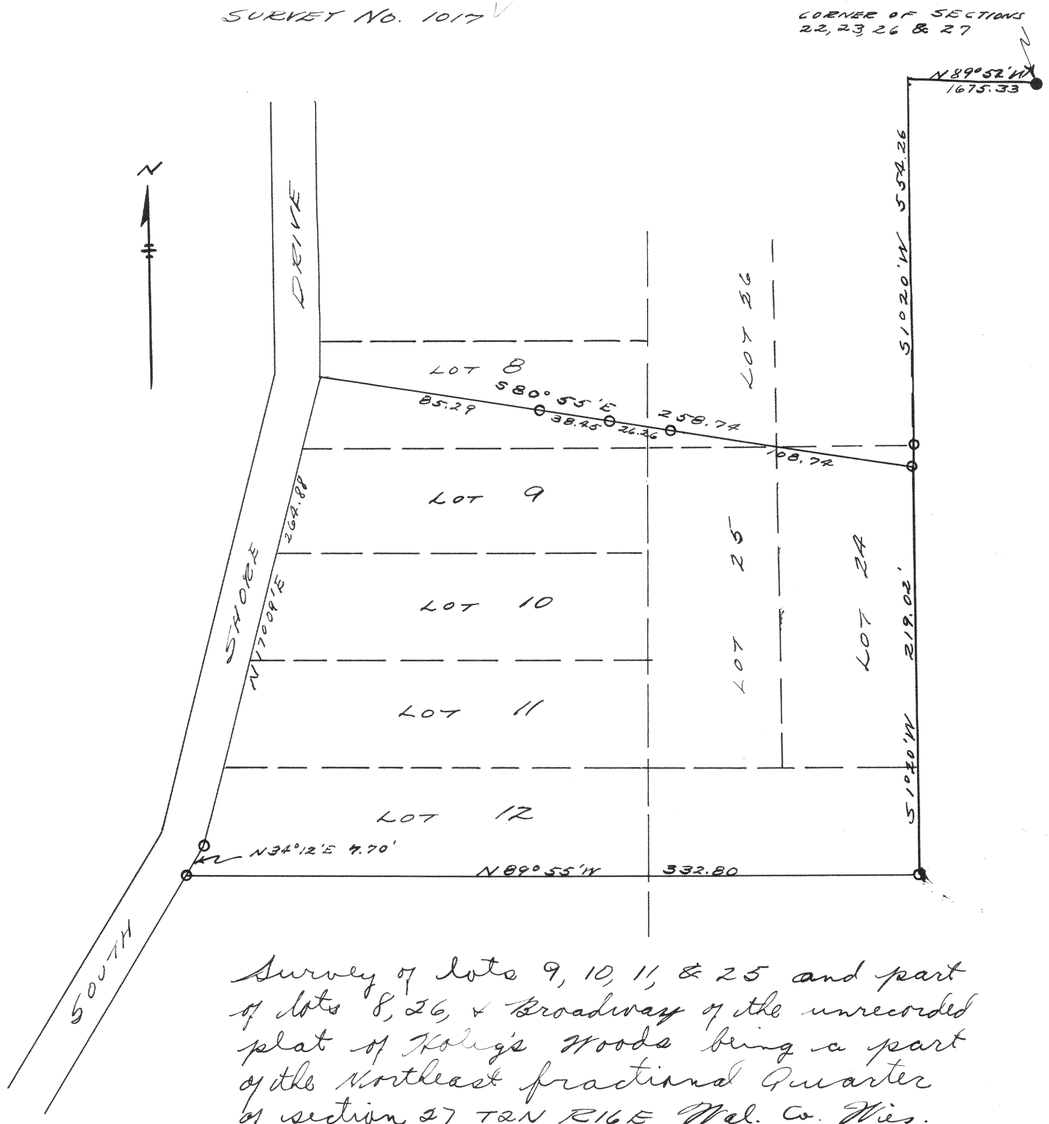

Survey of lots 9, 10, 11, & 25 and part of lots 8, 26, & Broadway of the unrecorded plat of Kolig's Woods being a part of the Northeast fractional Quarter of section 27 T2N R16E Wal. Co. Wis.
Nov. 1939

Lloyd L. Jensen
R. C. E.

SURVEY NO. 1018

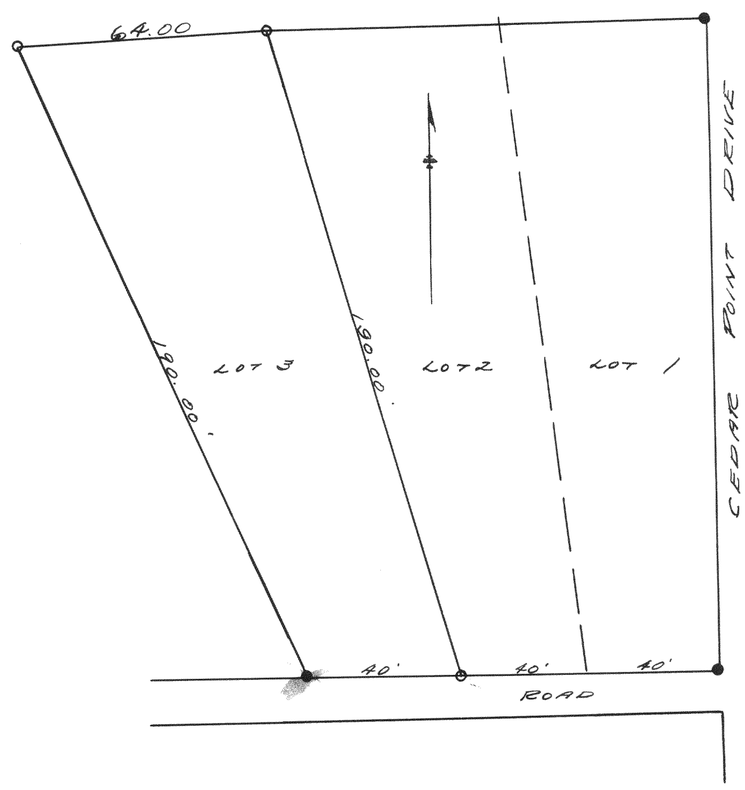

Survey of lot 3 of the first Addition to Cedar Point Park in the Village of Williams Bay, Walworth County, Wisconsin
Nov. 1939

Lloyd L. Jensen
R. C. E.