
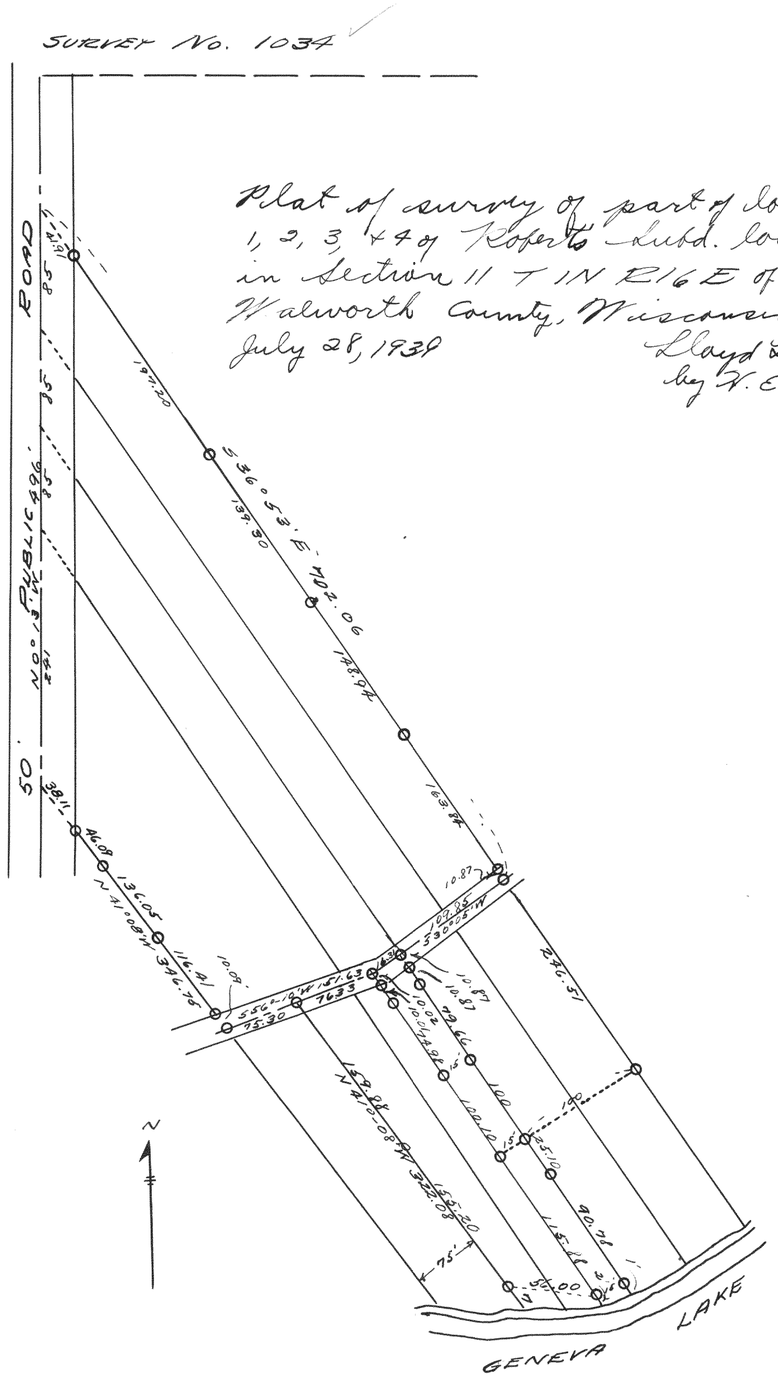


Plat of survey of part of lots 1, 2, 3, & 4 of Roberts Subd. located in Section 11 T 1N R 16 E of Walworth County, Wisconsin.
July 28, 1939

Lloyd L. Jensen
by W. E. J.

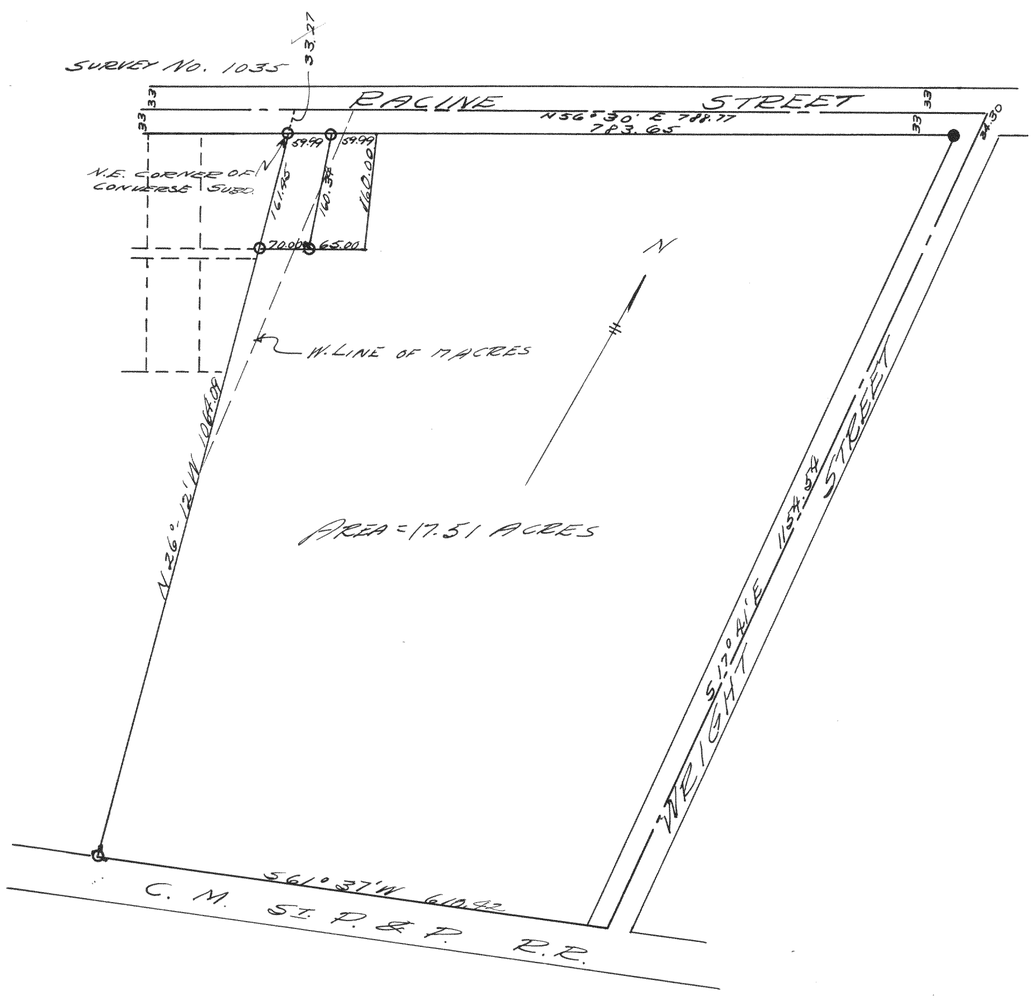

Survey of 17.51 acres of land located in the North ½ of Section 17 T2N R16E of Walworth County and in the city of Delavan, Wisconsin

October 30, 1939

Lloyd L. Jensen
by W. E. J.