Record of Survey.

No. 95 Block 20 of Marion

Township ....., North of Range ..... of 4 Principal Meridian as presented by the courses and distances on the following plat, and annexed field-notes of survey: Barker Lumber Co.

Established the center of the section at the point of intersection of STRAIGHT quarter lines.

Established all quarter-quarter corners upon the section boundary at proportional distances between known section and quarter section corners, according to the original field-notes of the Government survey.

Established all lost corners at proportionate distances between known corners, according to the original field notes of the Government survey.

From iron stake at NW. cor. of Blk. 7, west at Right angles to Wisconsin Str. 66 feet and made pt. for W. line of Street and at N.E. cor. of Blk. 22, found iron stake. From this NW at Right angles to Fremont Street, 66 feet is 615 feet in shed. Find stake hole at S.W. corners of Blk. 20, drive pipe and from this run line (or offset) over pt. 66 feet NW of NE. cor. of Blk. 22 and at intersection with W. line of Str. Set S.E. cor of Blk. being 4' SE and 9" Var. 5° W of S E cor. of platform of scales, 124.1 feet north of this stake set NE. cor. being 49.9" (49.9) from center of track. From SW. cor. N 124.1 set stake for NW. cor of Blk. 49.6" Var. from center of track, N 8 S lines are 284 feet.

Surveyed by William Childs C.S.

Recorded by Lloyd S. Jensen C.S.
Jan 20, 1934

Plat of Section ....., Township ..... North, Range ..... of 4 Principal Meridian Scale 80 chains to 6 inches. The figures in red ink are the lengths of the lines as stated in the field-notes of the Government survey.

Declination of the Magnetic Meridian from the True Meridian .....

Surveyed and sub-divided ..... A. D. 1 , in accordance with the State Laws and Instructions of the Commissioner of the General Land office, and recorded on pages ..... of Register in the County Clerk's office.

Witness my hand this ..... day of ..... A. D. 1

..... SURVEYOR.


DESCRIPTION

OF SECTION, QUARTER SECTION AND QUARTER QUARTER SECTION CORNERS

N. C. MILLER CO. MFG. STATIONERS, MILWAUKEE X15000

GOVERNMENT CORNERS	Bearing Trees	In. Dia.	Courses they bear	Links Distant	Bearing Trees	In. Dia.	Courses they bear	Links Distant	Bearing Trees	In. Dia.	Courses they bear	Links Distant	Bearing Trees	In. Dia.	Courses they bear	Links Distant
No.																
1. N. W. Sec. Cor. indentified, No. 96																
2. N. E. Sec. Cor. indentified,																
3. S. E. Sec. Cor. indentified,																
4. S. W. Sec. Cor. indentified,																
5. N. ¼ Sec. Cor. indentified,																
6. E. ¼ Sec. Cor. indentified,																
7. S. ¼ Sec. Cor. indentified,																
8. W. ¼ Sec. Cor. indentified,																
Subdivision Corners																
No.																
1. Center ¼ Sec. Cor.																
2. North ¼-¼s N. W. qr.,																
3. East ¼-¼s N. W. qr.,																
4. South ¼-¼s N. W. qr.,																
5. West ¼-¼s N. W. qr.,																
6. Center ¼-¼s N. W. qr.,																
7. North ¼-¼s N. E. qr.,																
8. East ¼-¼s N. E. qr.,																
9. South ¼-¼s N. E. qr.,																
10. Center ¼-¼s N. E. qr.,																
11. East ¼-¼s S. E. qr.,																
12. South ¼-¼s S. E. qr.,																
13. West ¼-¼s S. E. qr.,																
14. Center ¼-¼s S. E. qr.,																
15. South ¼-¼s S. W. qr.,																
16. West ¼-¼s S. W. qr.,																
17. Center ¼-¼s S. W. qr.																

J. Storey 26-1-15

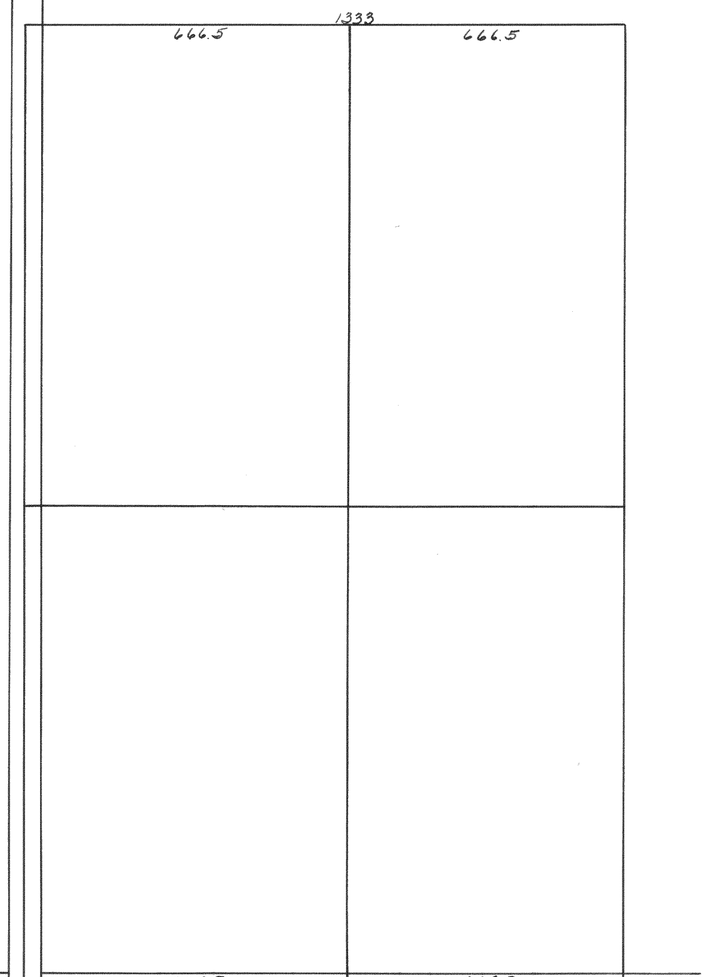


NAMES OF SWORN ASSISTANTS

CHAINMEN FLAGMEN AXMEN

Plat of part of section 26-1-15 by William Childs - County Surveyor.

Recorded by Lloyd S. Jensen C.S.
Jan. 22, 1934

No. 97

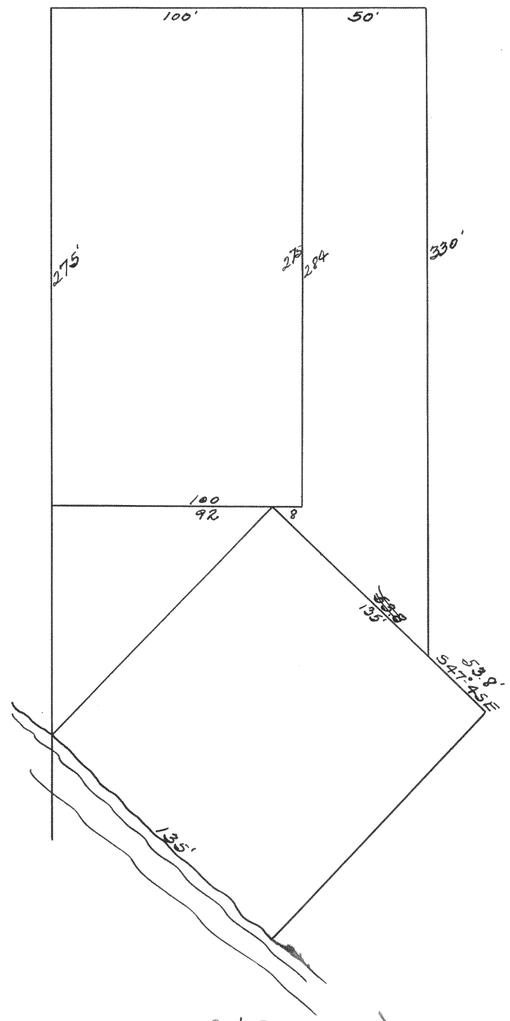

Plat of land for Anderson of Turtle Lake.
William Childs
C.S.

Recorded by Floyd S. Jensen C.S.
Jan 22, 1934

No. 98

This is to certify, that I have this day completed a survey made by the direction of C. S. Von Suesamilch, attorney for Frank Boehm, of that portion of the Northeast quarter of Section 12, T31 N, R15E, W Polk County, Wisconsin, lying North of the highway, and find

That the amount of land in said quarter section lying west of one certain line of fence which has been adhered to for several years prior to the Fall of 1906, does not exceed one-half of all of that part of the West half of the Northeast quarter of said Section number 12

Dated, August 27, 1908 William Childs C.S.

Recorded by Floyd S. Jensen C.S.
Jan. 22, 1934