350

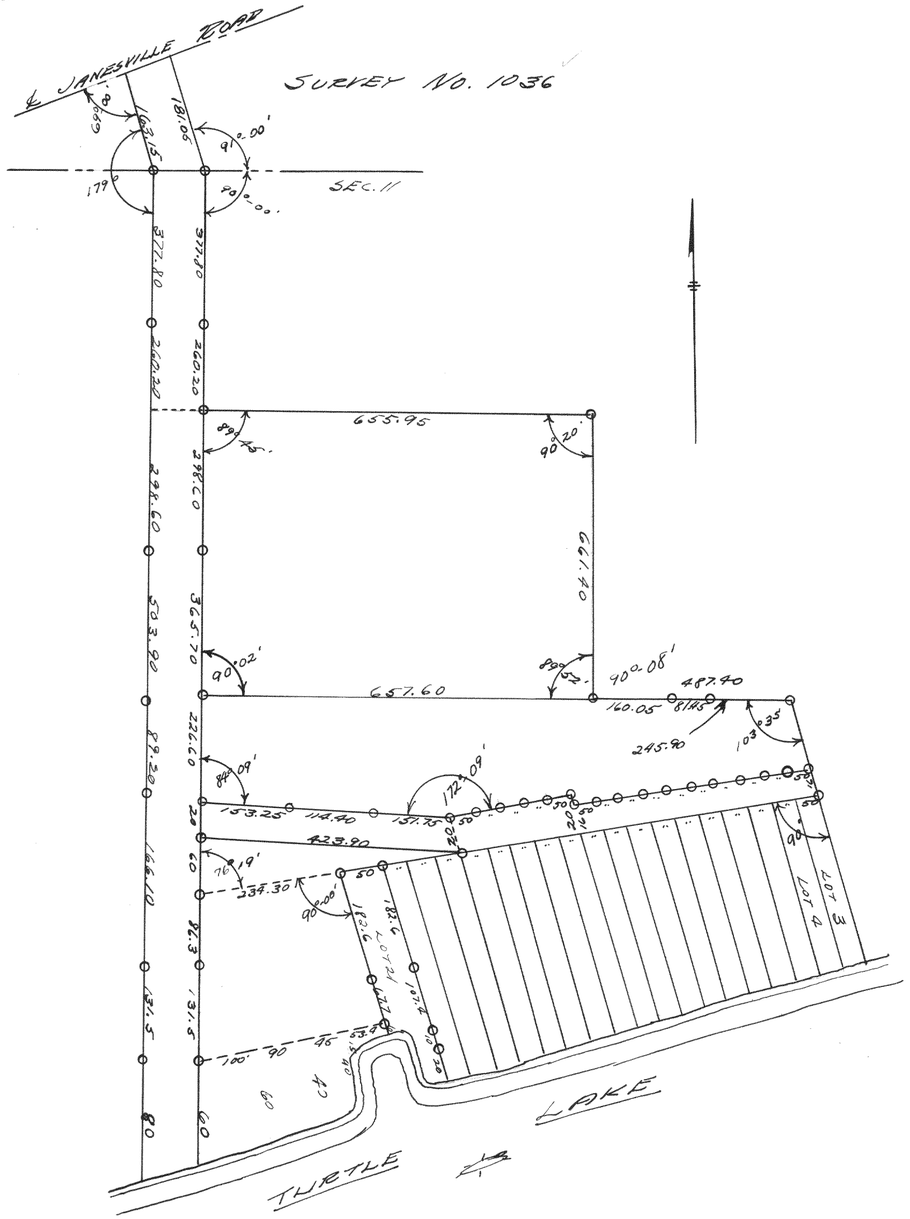

Survey of part of section 11 T3N R15E, Walworth County, Wisconsin

8-10-38

Lloyd L. Jensen
by W. E. J.

Recorded this date 1-15-40

SURVEY NO. 1037

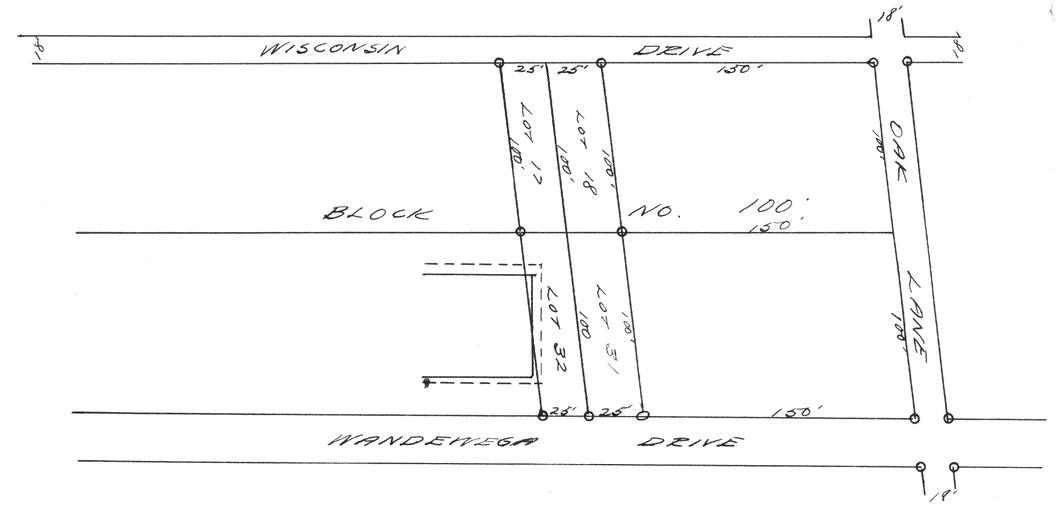

Survey of lot 17, 18, 19 & 20 of block no. 100 of Lake Wandenega Subd. T3N R16E, Walworth County, Wisconsin

Nov. 1939

Lloyd L. Jensen
by W. E. J.