

350

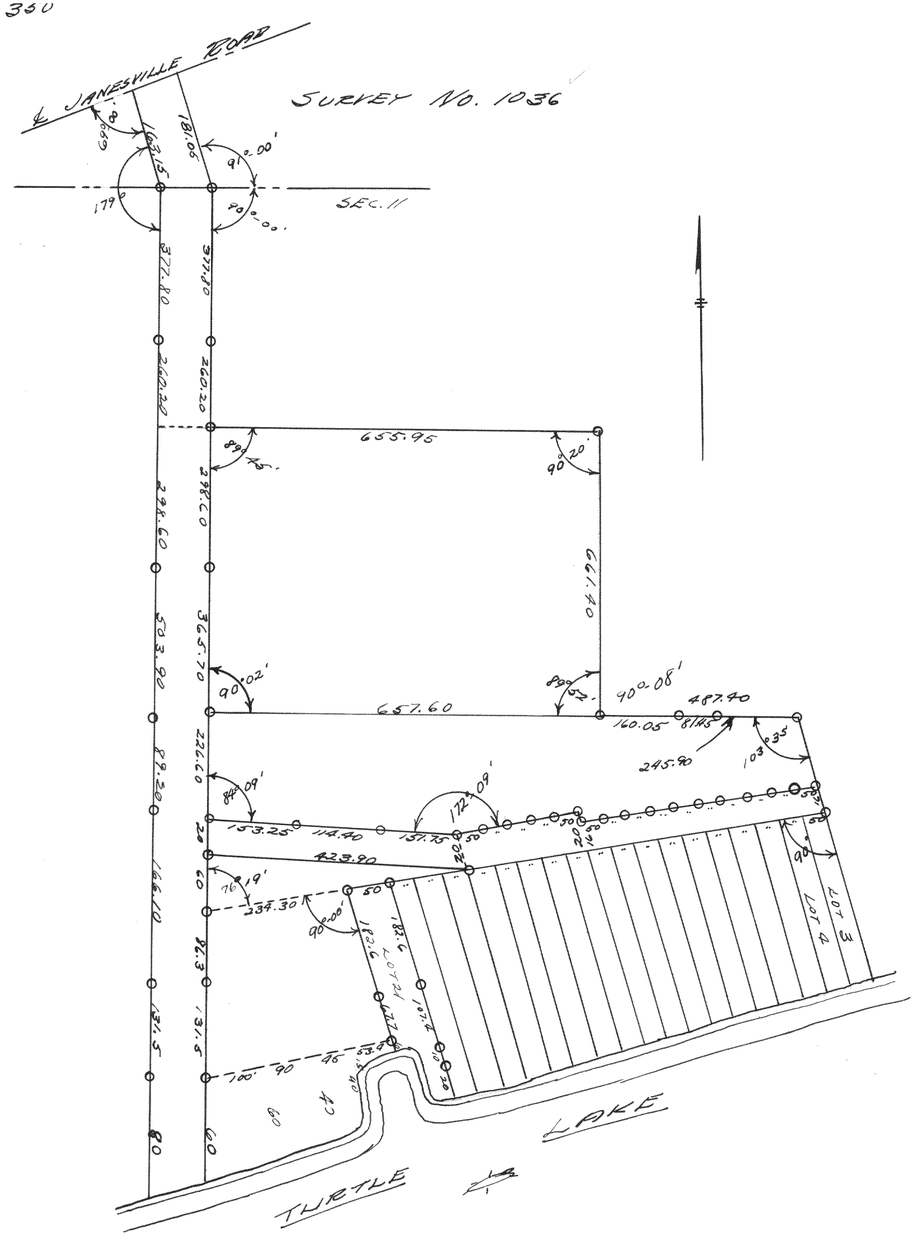

Survey of part of section 11 T3N R15E, Walworth County, Wisconsin

8-10-38

Lloyd L. Jensen
by W. E. J.

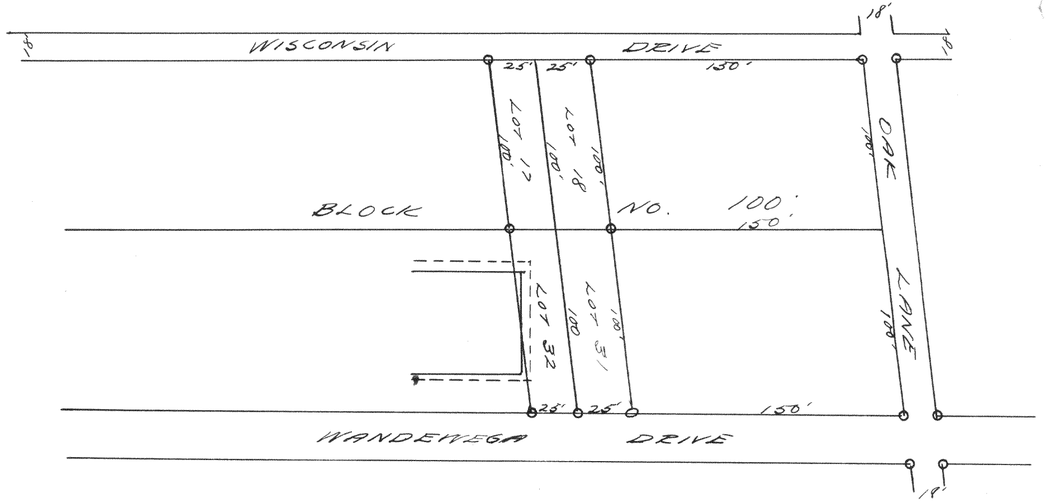


Nov. 1939

Lloyd L. Jensen
by W. E. J.