

SURVEY NO. 1038

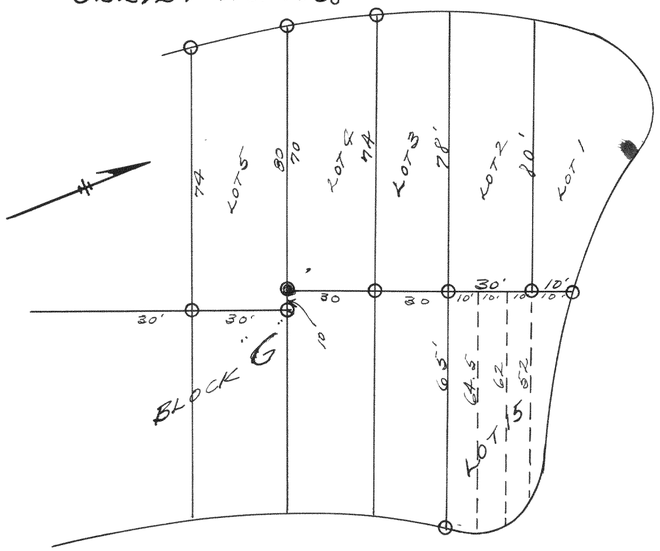

Survey of lots 4, 5 & 15 of Block G. of Delavan Lake Assembly Grounds T2N R16E, Walworth County, Wisconsin
Aug. 2, 1939
Lloyd L. Jensen
by K.E.J.

SURVEY NO. 1039
See Vol. page for complete drawing of Deakin Isle as resubdivided.
October, 1939
Lloyd L. Jensen
by K.E.J.


SURVEY NO. 1040

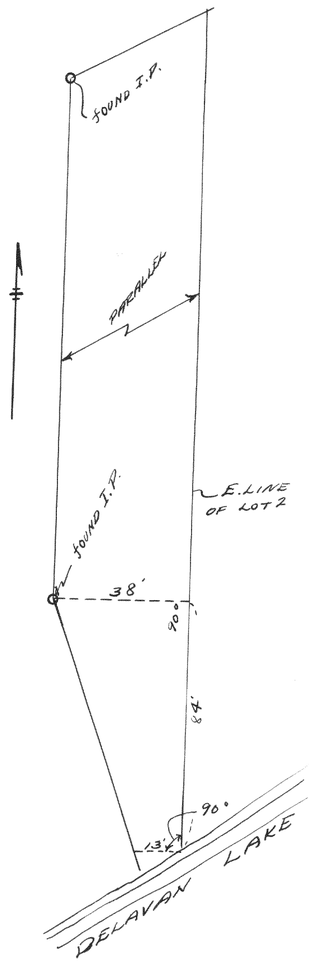

NOTE: SURVEY WAS BASED UPON TWO I. STAKES FOUND WHICH WERE NOT CHECKED.

Survey of part of Lot 2 of the plat of Eidon located in T2N R16E of Walworth County Wisconsin.
Nov. 1939
Lloyd L. Jensen
by K.E.J.

SURVEY NO. 1041

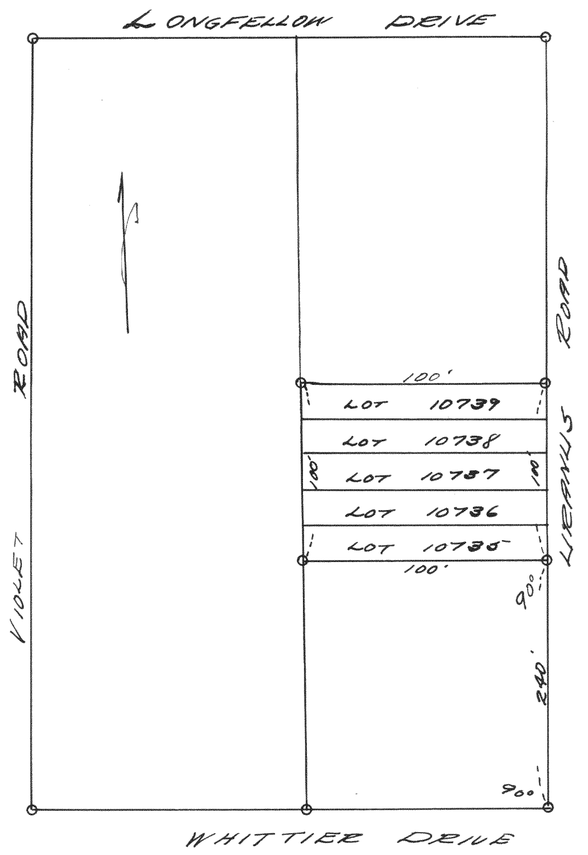

Survey of Lots 10739 to 10735 inc. of Lake Como Beach T2N R17E, Walworth County, Wisconsin
Nov. 9, 1939
Lloyd L. Jensen
K. E. J.