

352

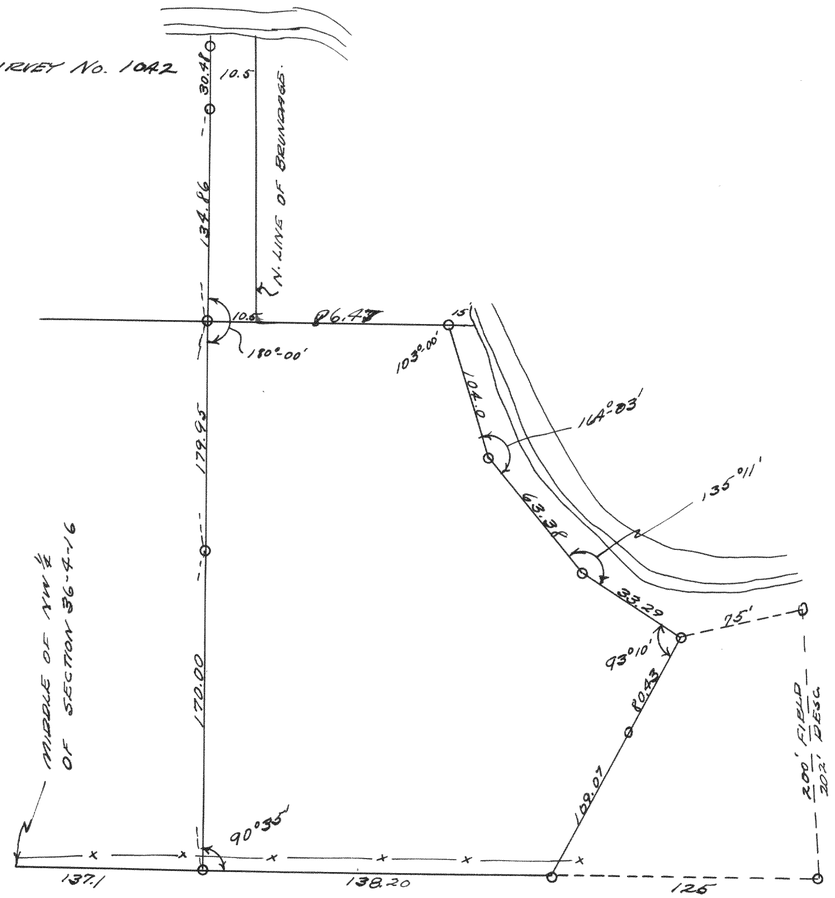

Survey of land in the NW. ¼ of Section 36 T4N R16E of Walworth County, Wisconsin

July 13, 1937

Lloyd L. Jensen
by W. E. J.

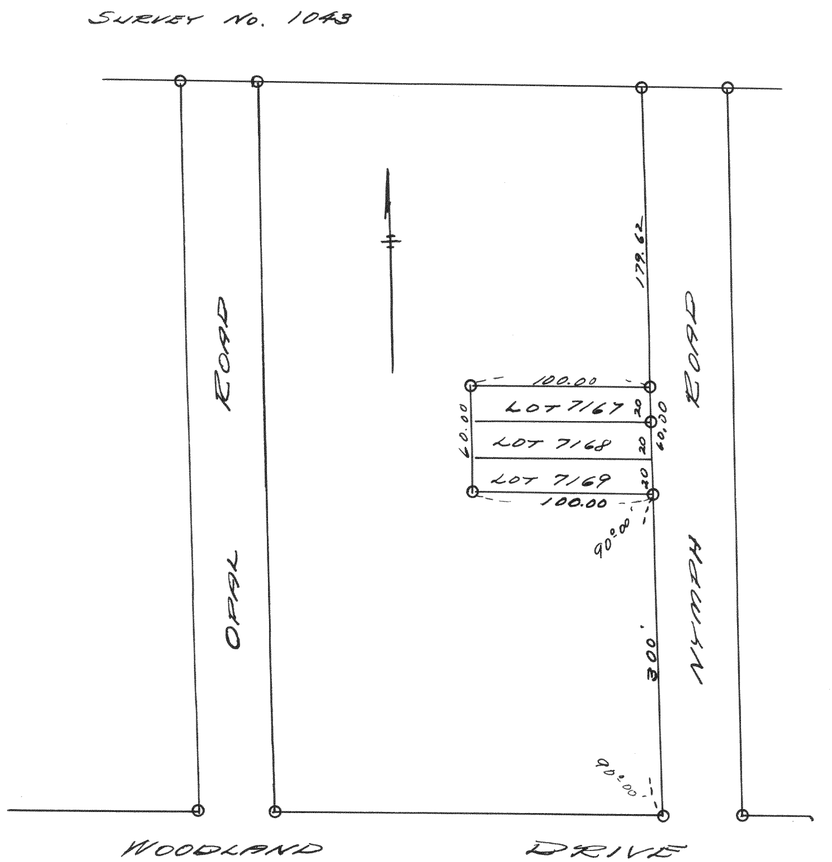

Survey of land in Lake Como Beach Subdivision T2N R17E of Walworth County, Wisconsin

Nov. 10, 1939

Lloyd L. Jensen
by W. E. J.