
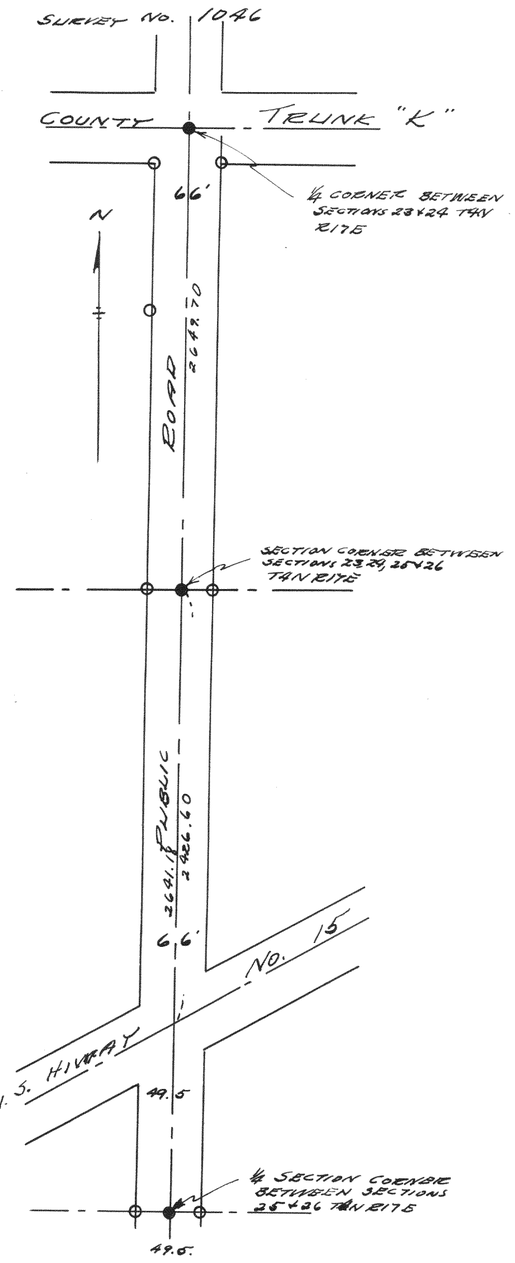



Survey made to locate road in sections 23, 24, 25 & 26 T4N R17E, Walworth County, Wisconsin

Nov. 1939 Lloyd L. Jensen N.E.J.

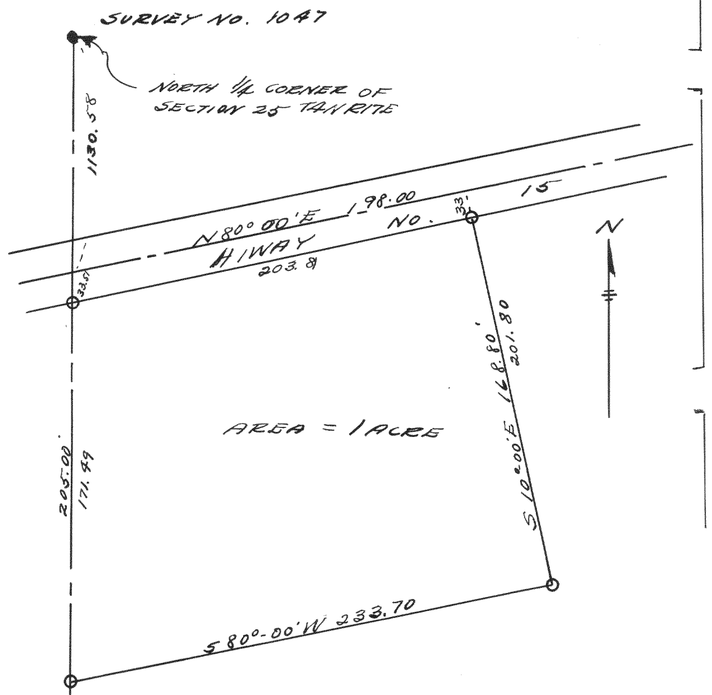


Survey of part of the Northeast Quarter of Section 25 T4N R17E

Aug. 17, 1939 Lloyd L. Jensen by N.E.J.

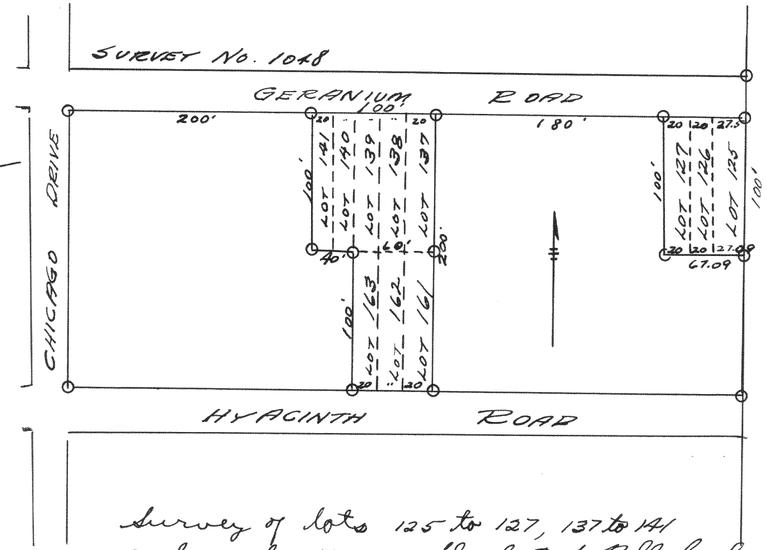

Survey of lots 125 to 127, 137 to 141 and 161 to 163 of Block 3 of Pell Lake Addition, a subdivision in sections 14 & 23 T1N R18E Walworth County, Wisconsin

Aug. 18, 1939 Lloyd L. Jensen by N.E.J.

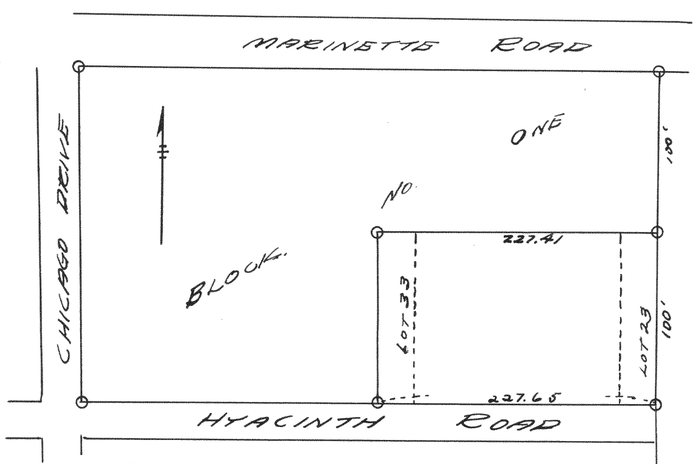

Survey of lots 23 to 33 of Block one of Pell Lake Addition

Aug. 11, 1939 Lloyd L. Jensen N.E.J.