
SURVEY No. 1050

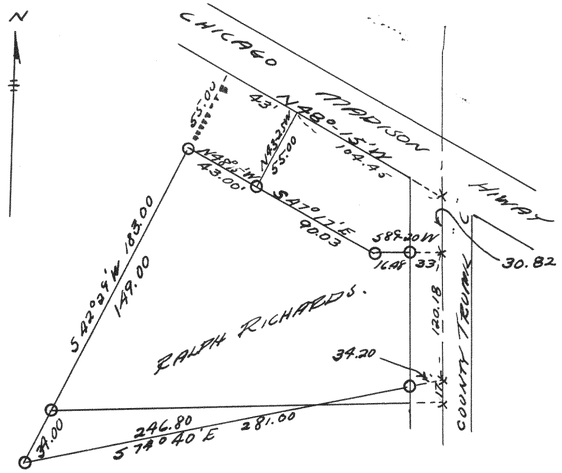


Survey of part of the SE ¼ of Section 27 – 1 – 15

January 9, 1940

Lloyd L. Jensen by V. E. J.

SURVEY No. 1051

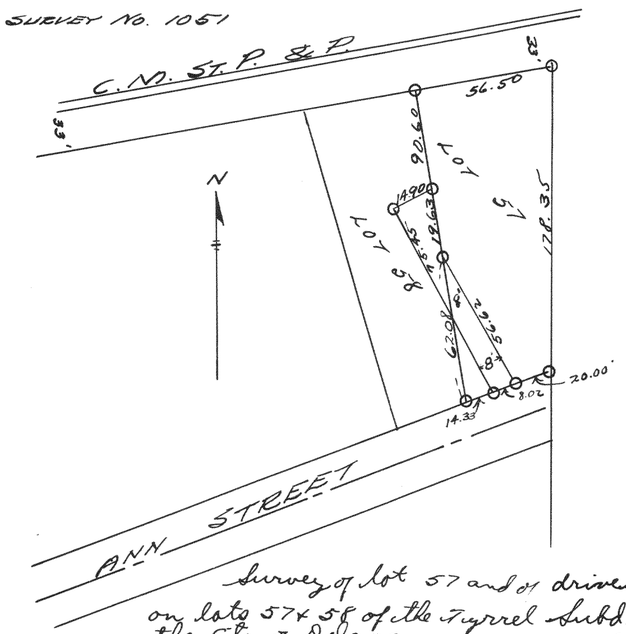


Survey of lot 57 and of driveway on lots 57 & 58 of the Tyrrel Subd. in the City of Delavan

Nov. 9, 1939

Lloyd L. Jensen by V. E. J.

SURVEY No. 1052

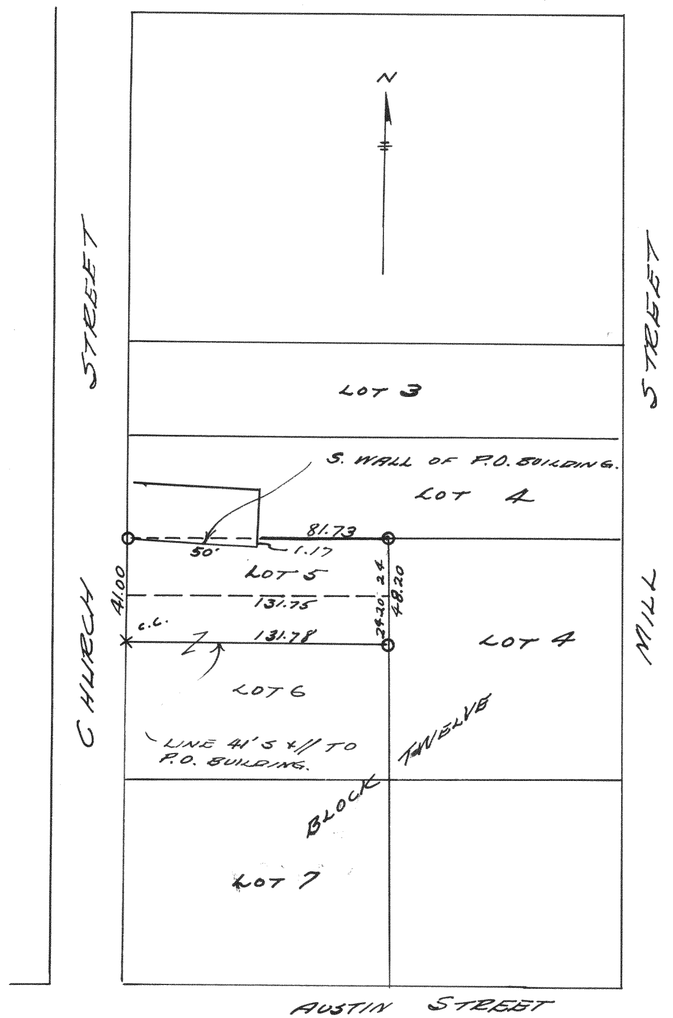


Survey of part of lots 5 & 6 of Block 12 of the original village of East Troy.

9-18-39

Lloyd L. Jensen by V. E. J.

SURVEY No. 1053

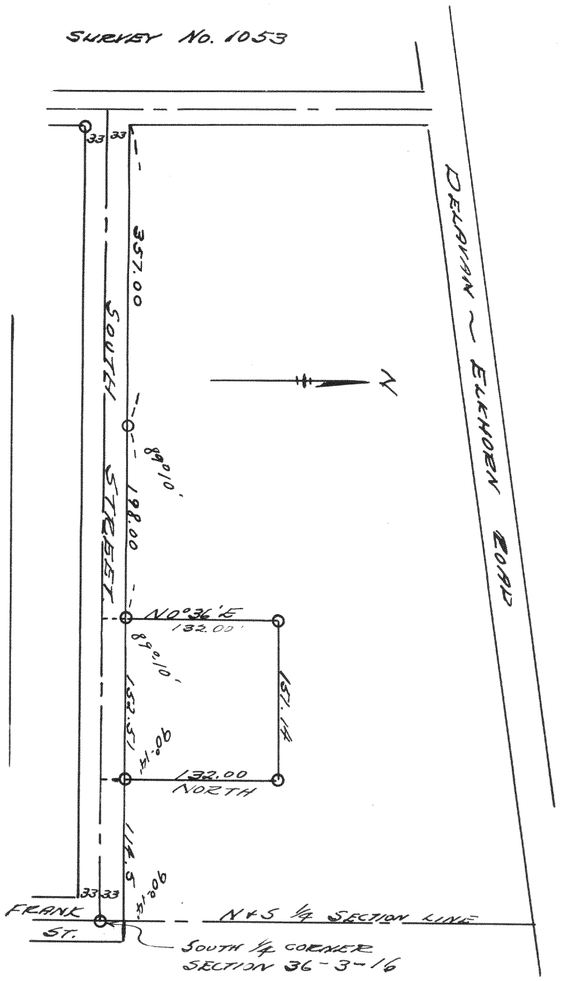

Survey of a parcel of land in the southwest quarter of section 36 T3N R16E, Walworth County, Wisconsin

Aug. 17, 1939

Lloyd L. Jensen by V. E. J.