
SURVEY No. 1059

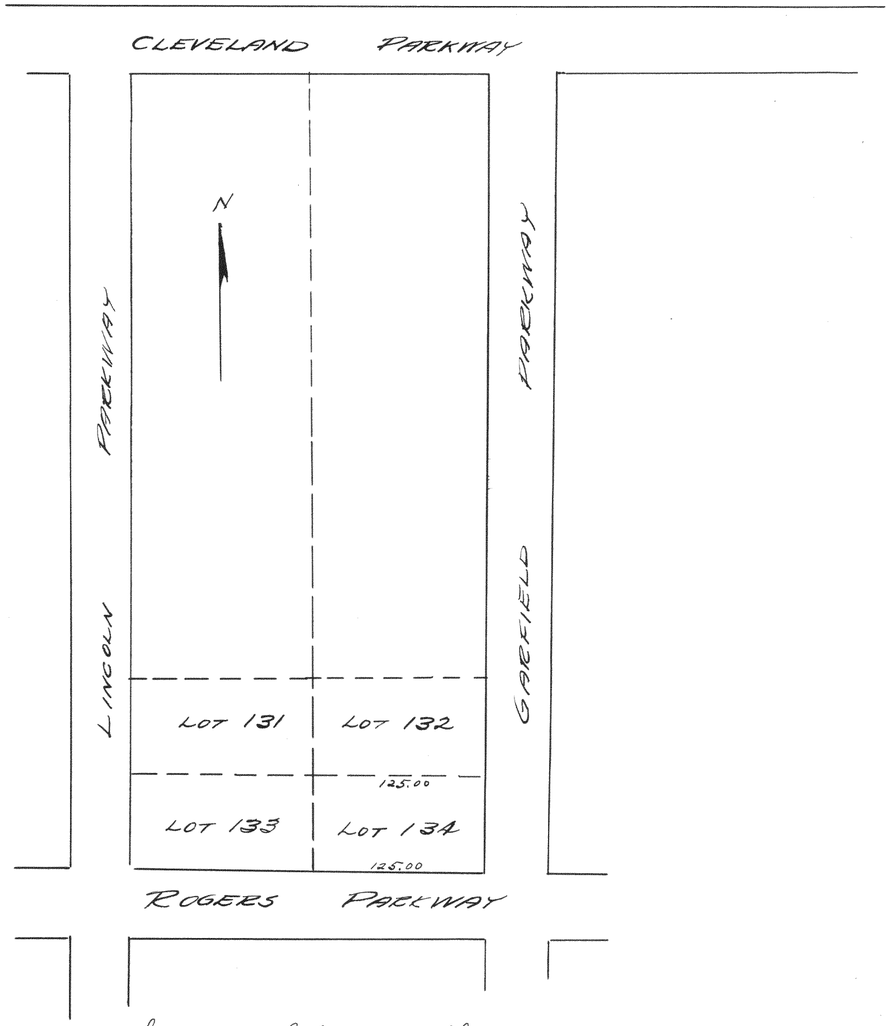


Survey of lot 134 of the original Cedar Point Park Subdivision in the Village of Fontana Bay, Walworth County, Wisconsin

Nov. 1939

Lloyd L. Jensen
by W. E. J.

SURVEY No. 1060

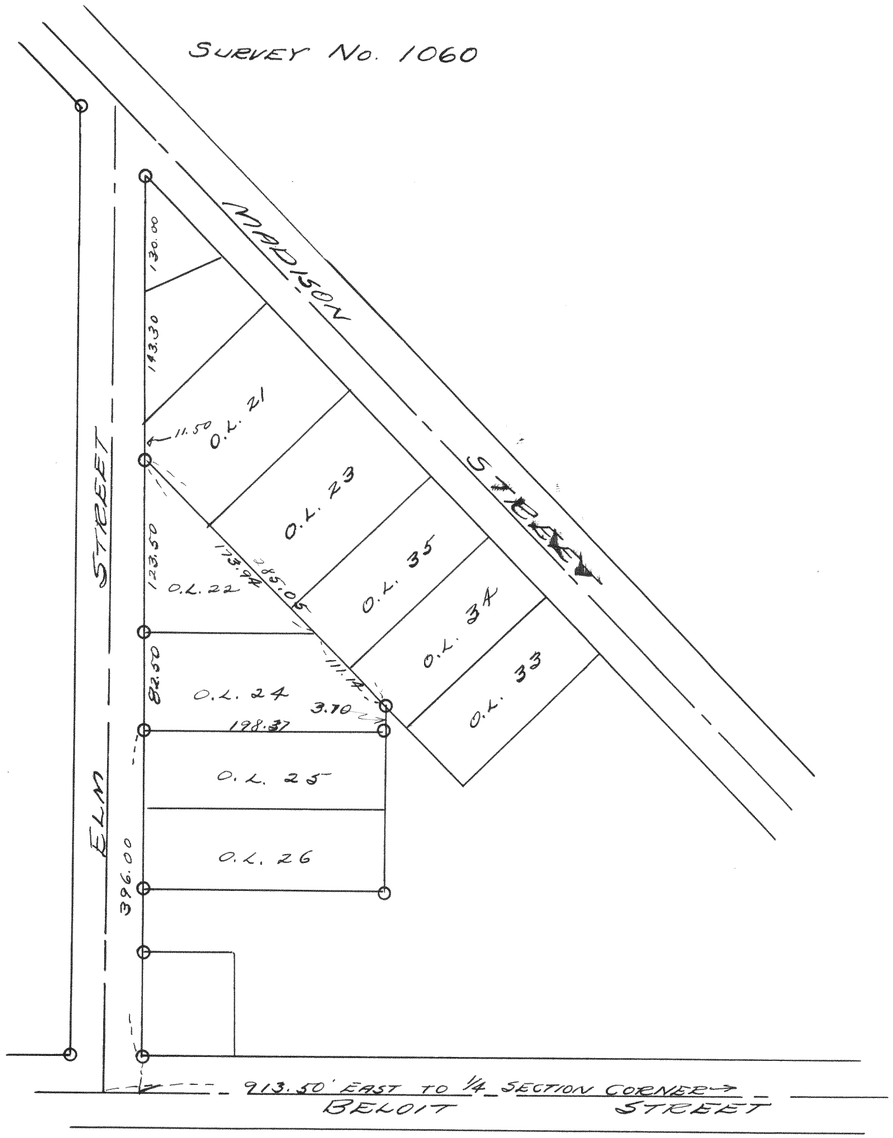

Survey of outlots 22 & 24 of the Village of Walworth, Walworth County, Wisc.

Dec. 14, 1939

Lloyd L. Jensen
by W. E. J.