
SURVEY NO. 1061

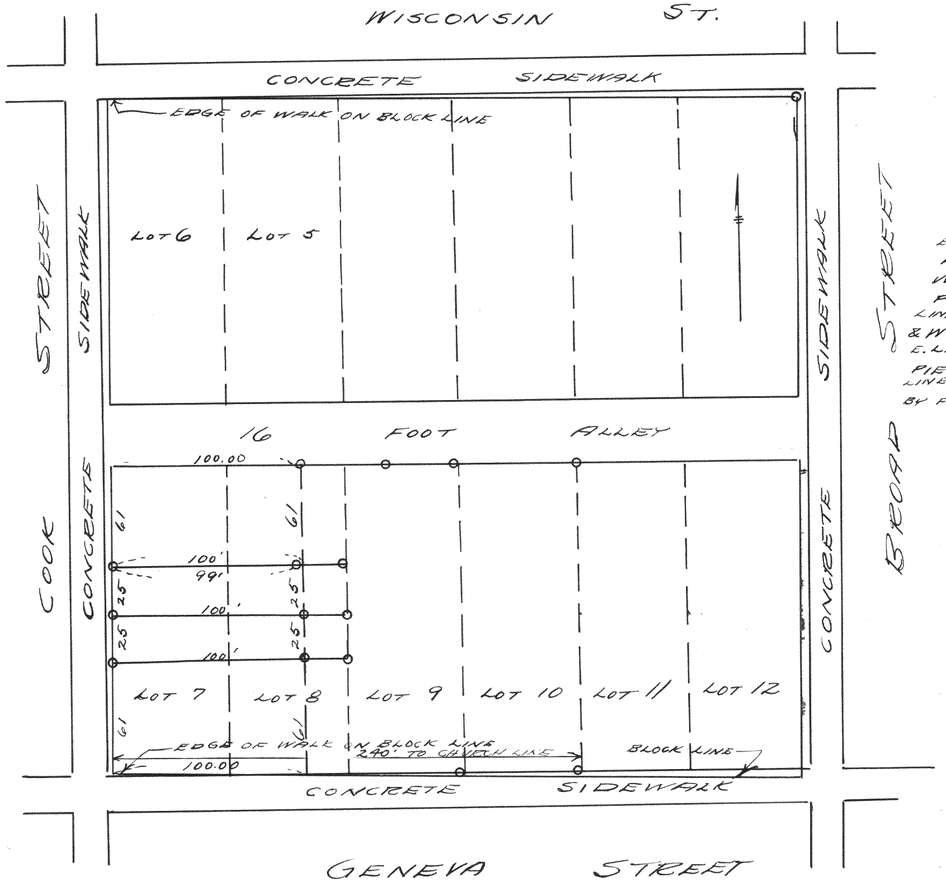


SURVEY OF THE NORTH 50 FT. OF THE WEST 100' OF THE SOUTH 111 FT. OF LOT 7 & 8 OF BLOCK 17 OF THE VILLAGE OF GENEVA, NOW CITY OF LAKE GENEVA, WALWORTH COUNTY, WISCONSIN.

JULY 1, 1939

Lloyd L Jensen
by K.E.J.


SURVEY NO. 1062

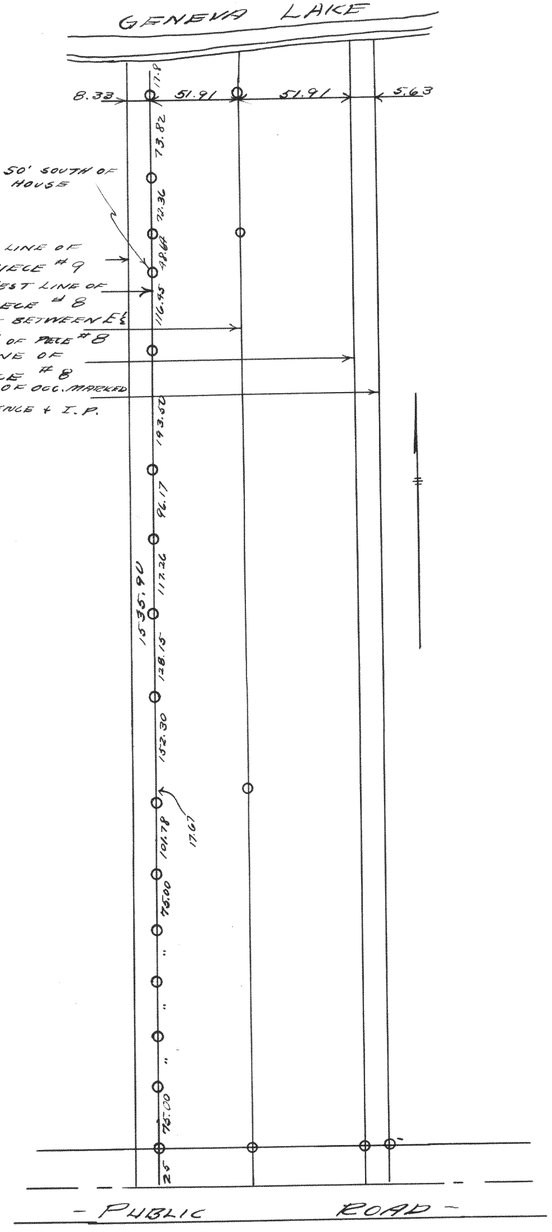

SURVEY OF WEST LINE OF PIECE #8 OF LOT #2 OF SECTION 18 T 1N R 17E

NOV. 1, 1939

Lloyd L Jensen
K.E.J.

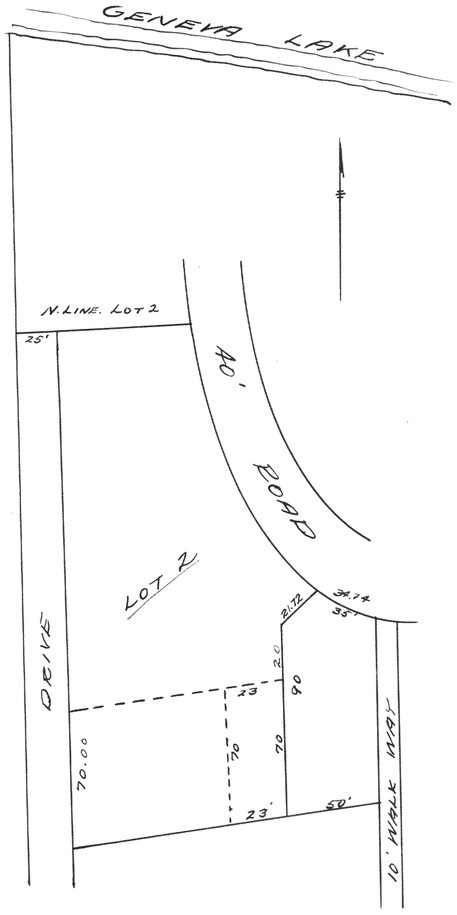

PLAT OF SURVEY OF PART OF LOT 2, BLOCK 2 OF WOODDALE ADDITION, A SUBDIVISION IN SECTION 16, T1N R17E, WALWORTH COUNTY, WISCONSIN

AUG. 24, 1939

Lloyd L. Jensen
by K.E.J.