SURVEY NO. 1061

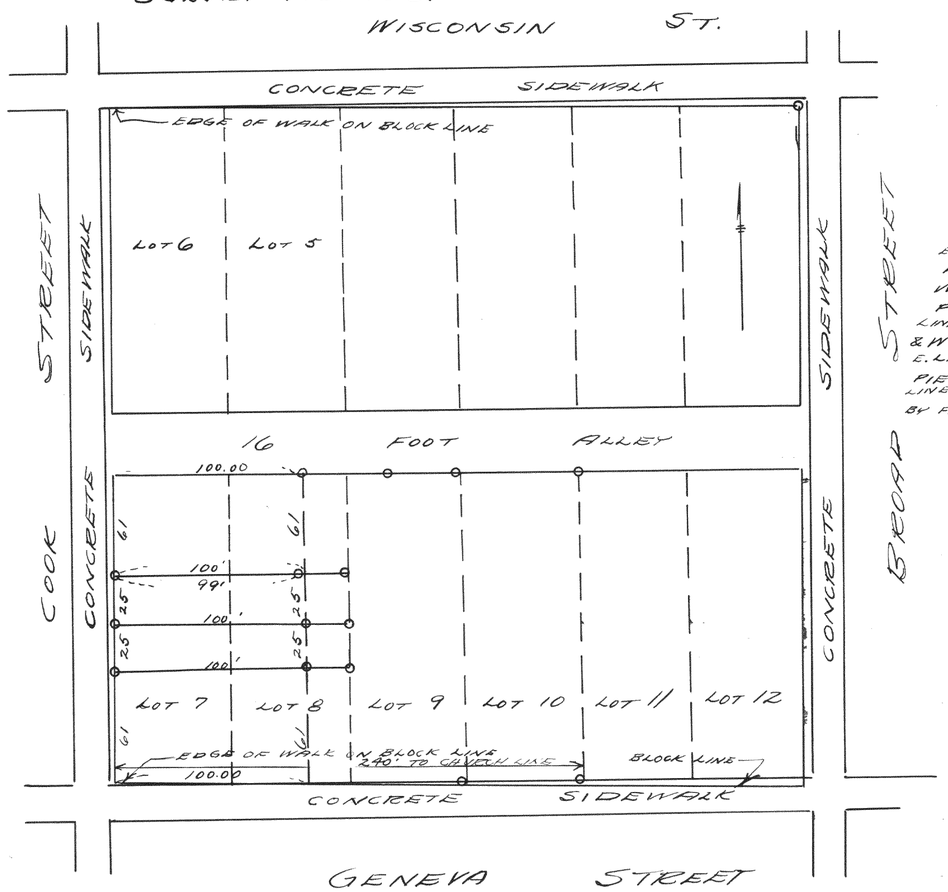

SURVEY OF THE NORTH 50 FT. OF THE WEST 100' OF THE SOUTH 111 FT. OF LOT 7 & 8 OF BLOCK 17 OF THE VILLAGE OF GENEVA, NOW CITY OF LAKE GENEVA, WALWORTH COUNTY, WISCONSIN.

JULY 1, 1939

Lloyd L. Jensen
by H.E.J.

SURVEY NO. 1062

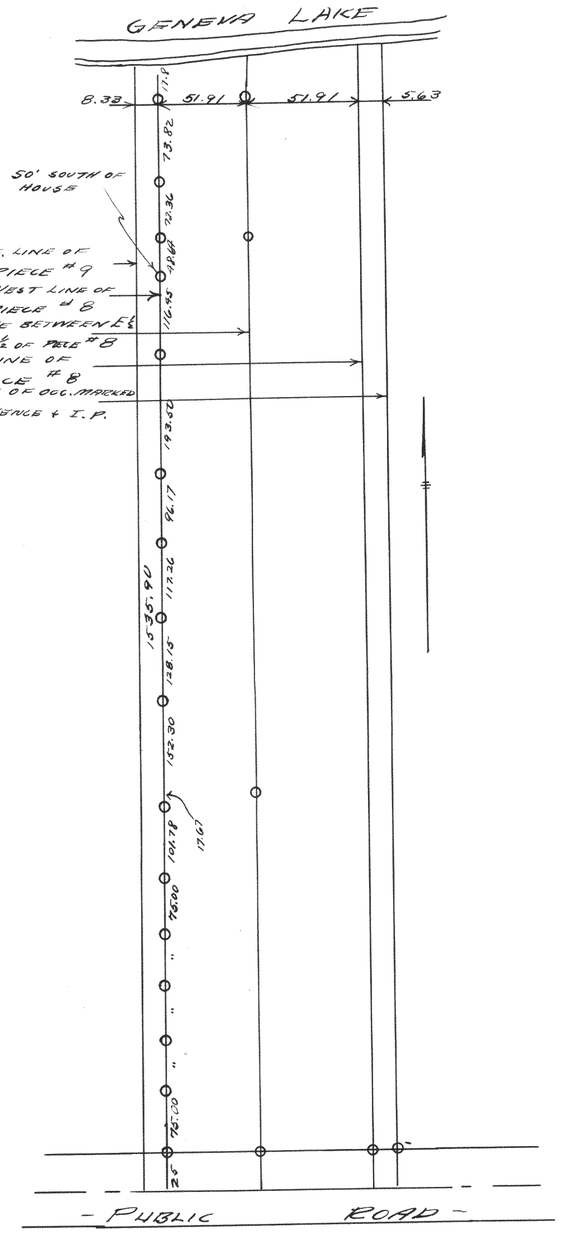

SURVEY OF WEST LINE OF PIECE #8 OF LOT #2 OF SECTION 18 T1N R17E

NOV. 1, 1939

Lloyd L. Jensen
H.E.J.

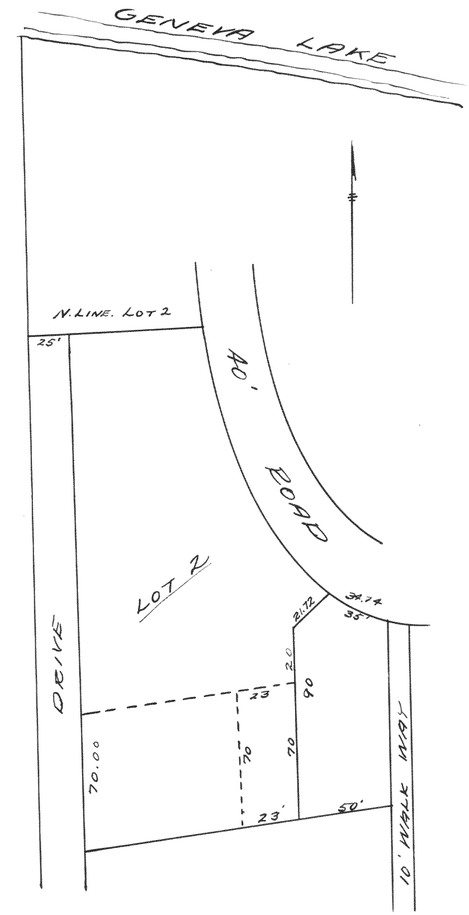

PLAT OF SURVEY OF PART OF LOT 2, BLOCK 2 OF WOODDALE ADDITION, A SUBDIVISION IN SECTION 16, T1N R17E, WALWORTH COUNTY, WISCONSIN

AUG. 24, 1939

Lloyd L. Jensen
by H.E.J.