

SURVEY NO. 1067

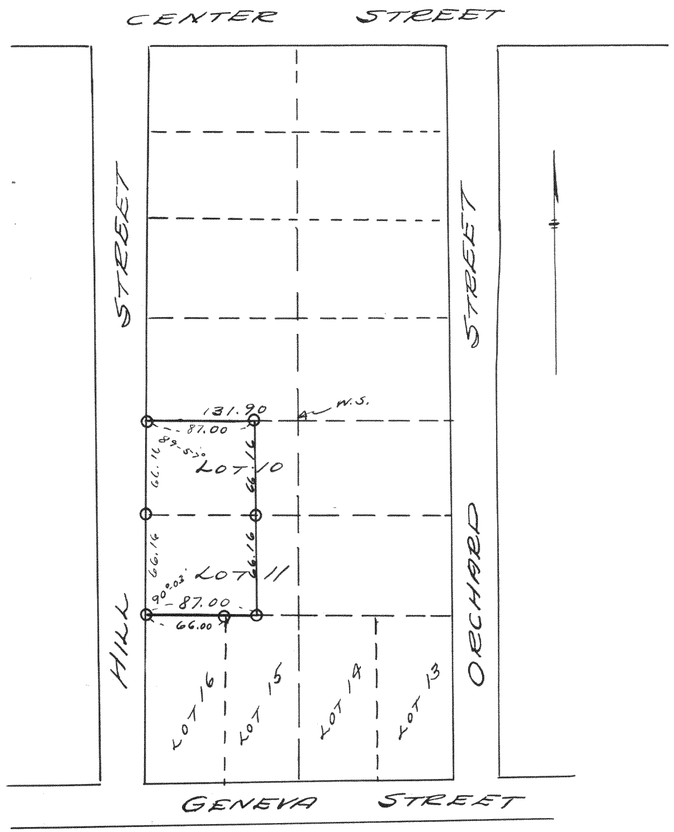

SURVEY OF LOTS 10 & 11 OF BLOCK 16 OF WILLIAMS 2ND ADD. TO THE VILLAGE OF WMS. BAY
9-19-39

Lloyd L. Jensen
K.E.J.


SURVEY NO. 1068

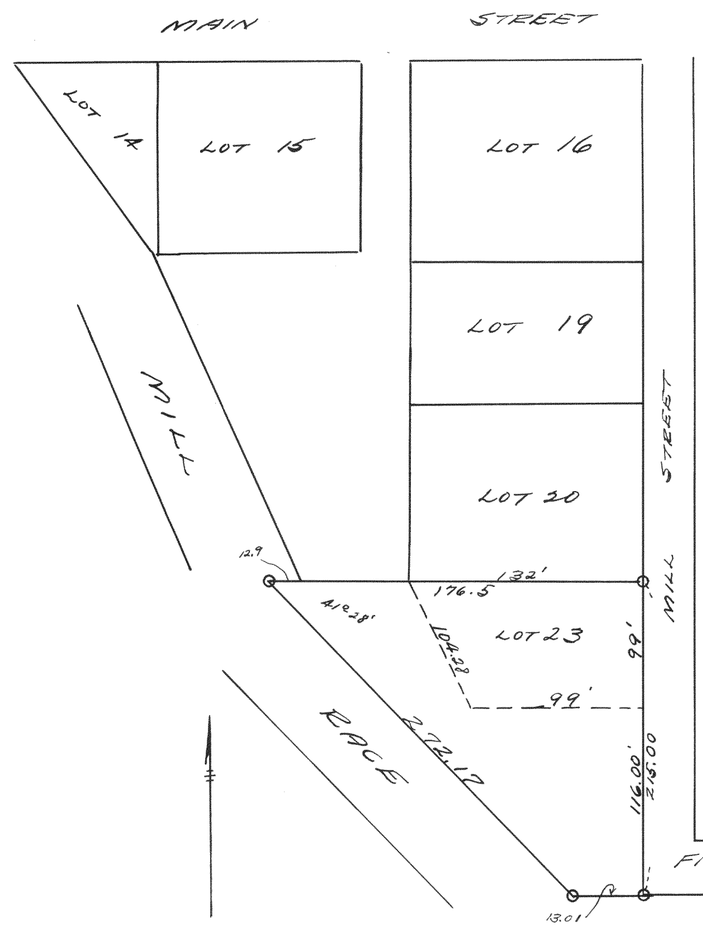

SURVEY OF LOT 23 OF THE ORIGINAL VILLAGE OF GENOA CITY AND ADJOINING PROPERTY.
APRIL 5, 1939

Lloyd L. Jensen
by K.E.J.

SURVEY NO. 1069

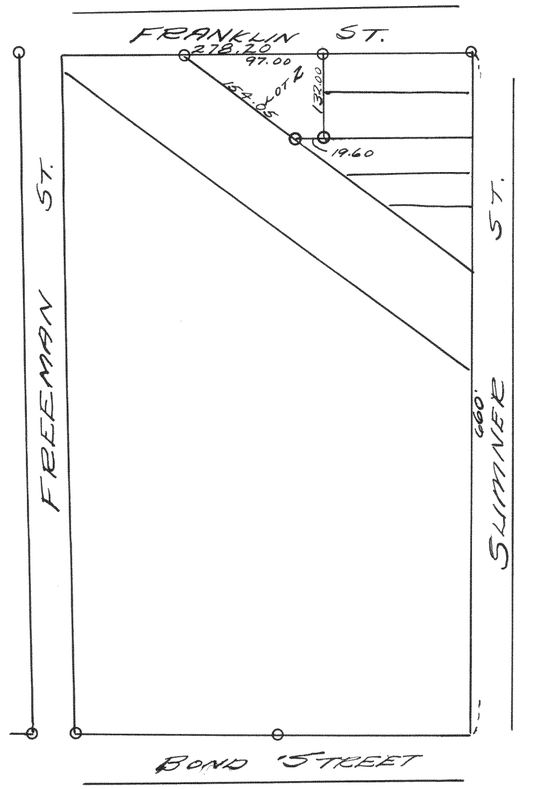

SURVEY OF LOT 2, BLK. 4 OF ROWE'S ADD. TO THE VILLAGE OF GENOA CITY.
10-39

Lloyd L. Jensen
by K.E.J.