

SURVEY No. 1070

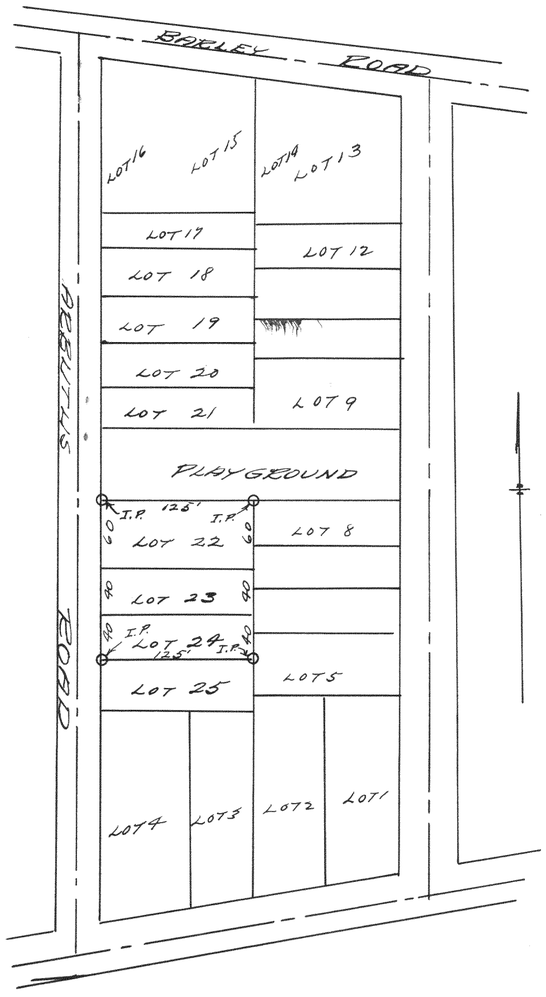

SURVEY OF LOTS 22, 23, & 24
OF BLOCK 45 OF PLAT IV
OF INTERLAKEN SUBDIVISION
4-18-39 Lloyd L. Jensen
K.E.J.


SURVEY No. 1071

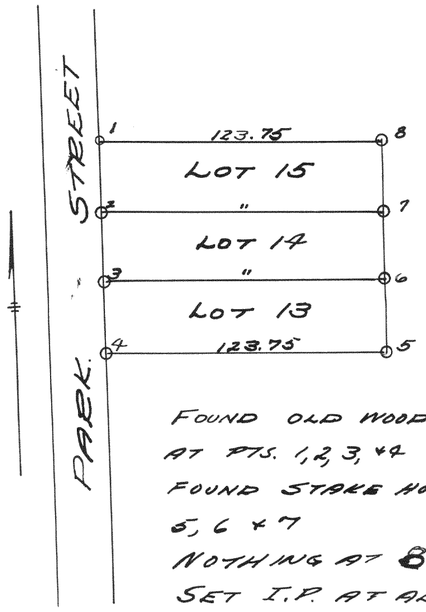

FOUND OLD WOOD STAKES
AT PTS. 1, 2, 3, & 4
FOUND STAKE HOLES AT
5, 6 & 7
NOTHING AT 8
SET I.P. AT ALL PTS.

SURVEY OF LOTS 13, 14 & 15
OF BLOCK I OF F.W. TRATTS
PARKLAWN ADDITION TO THE
CITY OF WHITEWATER
7-9-39 Lloyd L. Jensen
by K.E.J.

SURVEY No. 1072

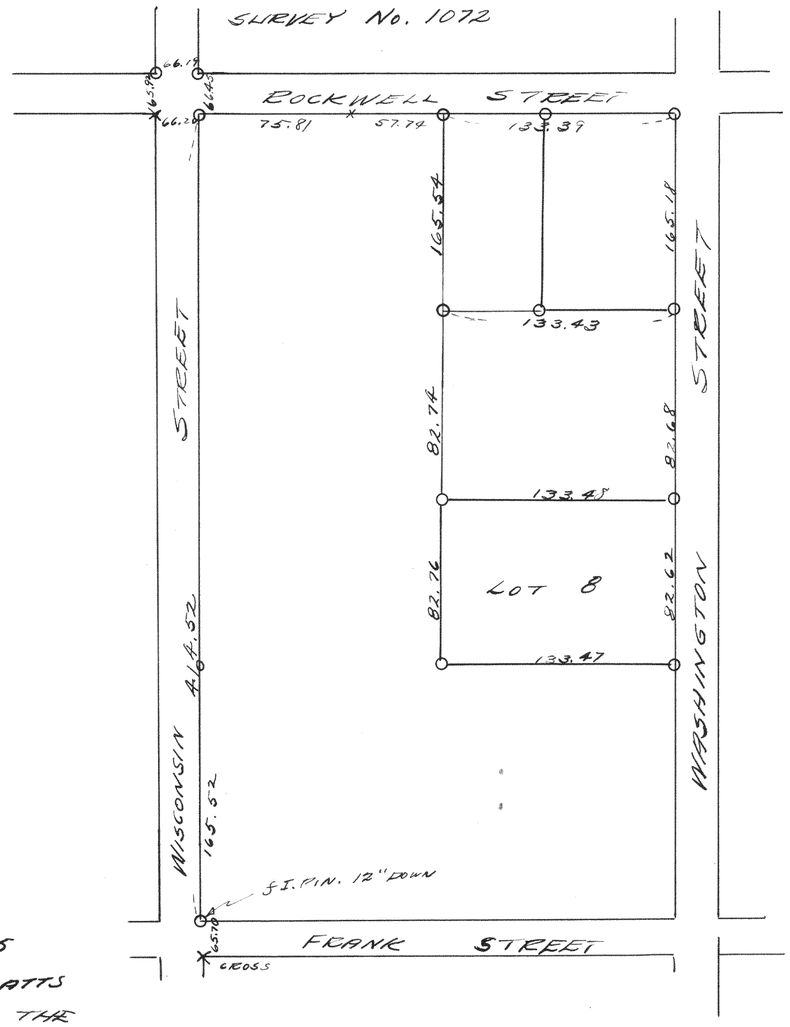

SURVEY OF LOT 8 OF BLOCK 43
OF "ROCKWELL'S 2ND ADD. TO
THE CITY OF ELKHORN
NOV. 1939 Lloyd L. Jensen
by K.E.J.