

SURVEY No. 1078

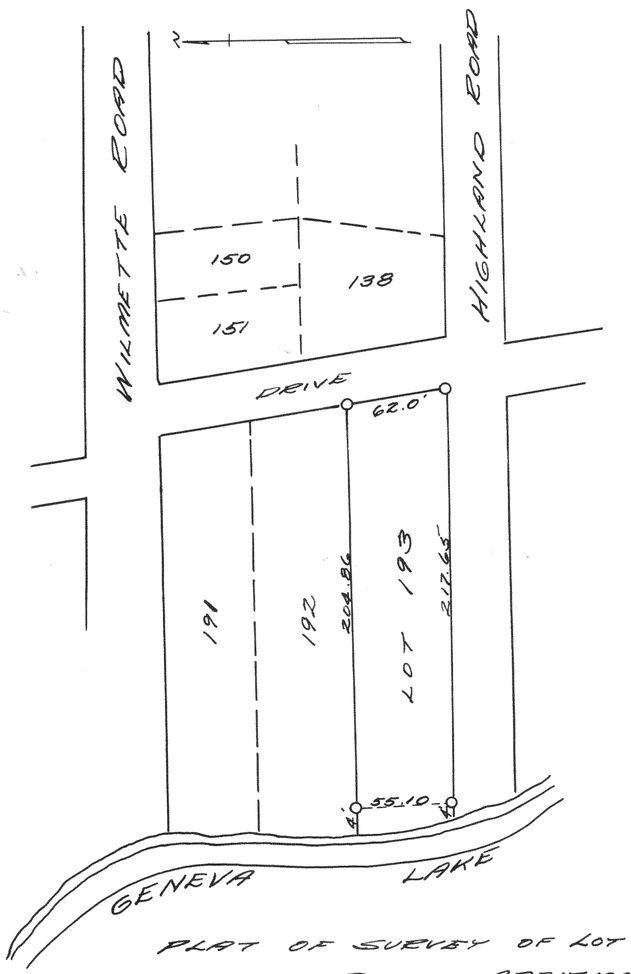


PLAT OF SURVEY OF LOT 193 OF THE SECOND ADDITION TO CEDAR POINT PARK
SEPT. 26, 1940
Lloyd L. Jensen

SURVEY No. 1079

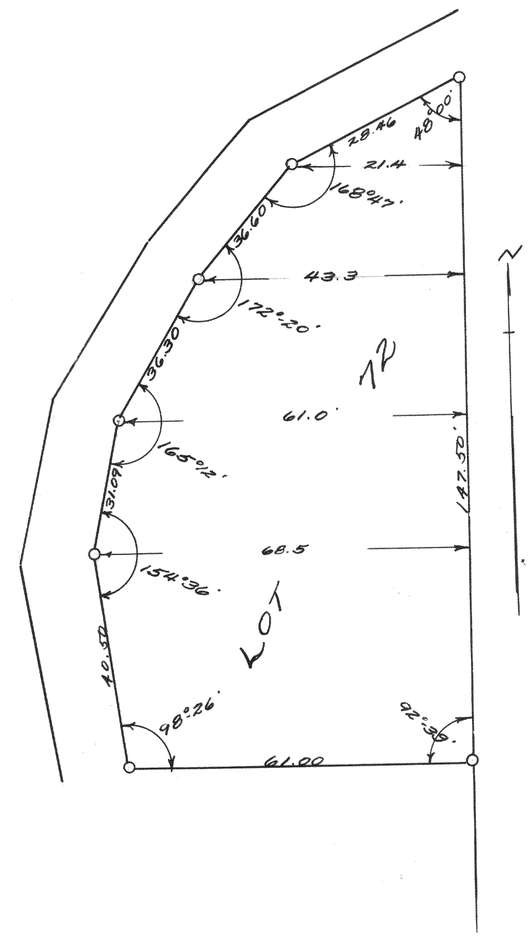

PLAT OF SURVEY OF LOT 72 OF CEDAR POINT PARK, WMS. BAY, WISCONSIN.
OCT. 22, 1940
Lloyd L. Jensen
M.E.

SURVEY No. 1080

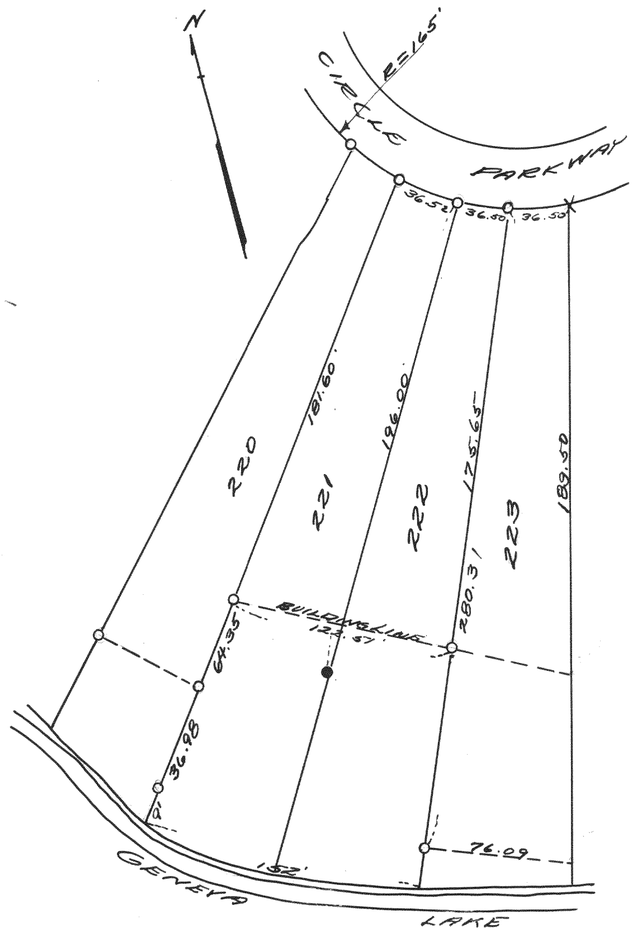

PLAT OF SURVEY OF LOTS 221 & 222 OF THE ~~3RD~~ ADDITION TO CEDAR POINT PARK, IN THE VILLAGE OF WMS. BAY, WALWORTH COUNTY, WISCONSIN.
Lloyd L. Jensen
M.E.J.