
SURVEY No. 1086

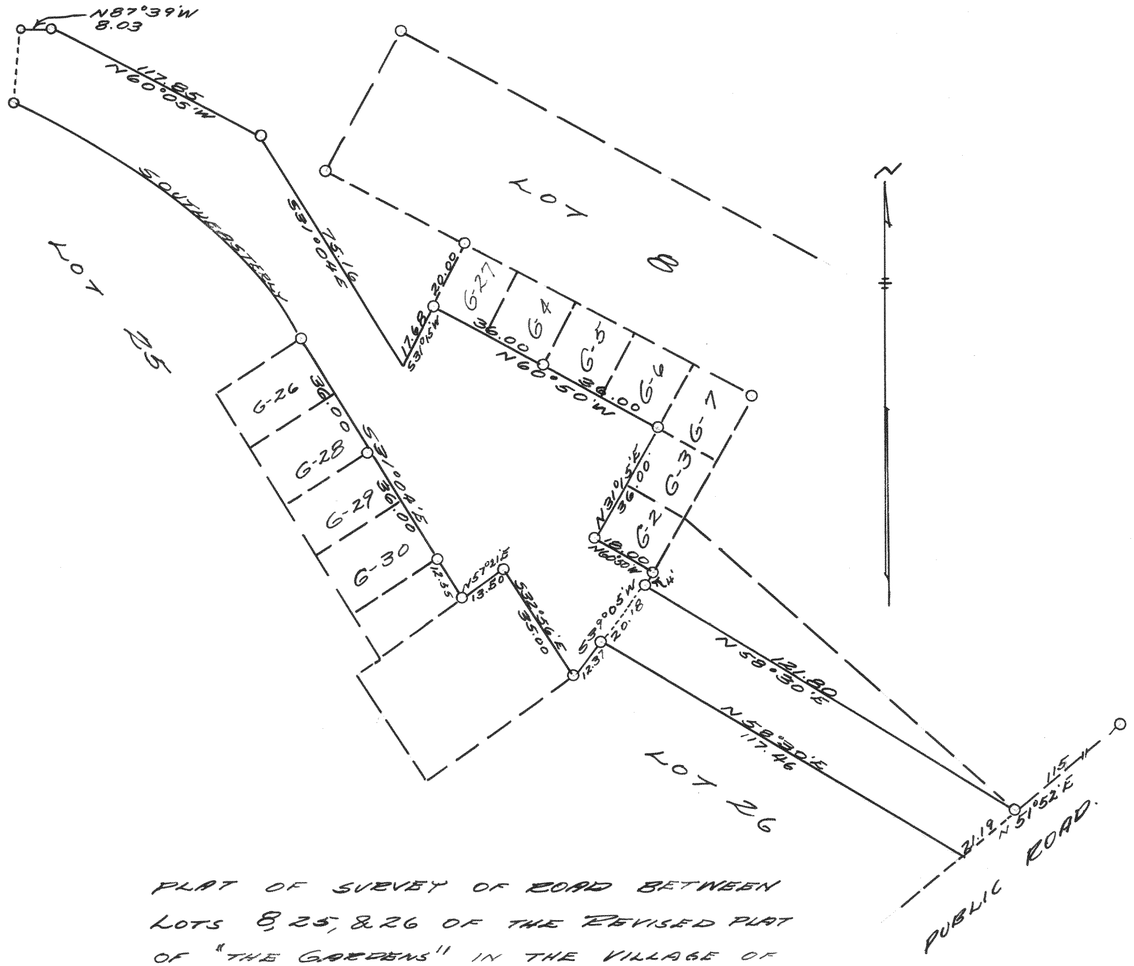


PLAT OF SURVEY OF ROAD BETWEEN LOTS 8, 25, & 26 OF THE REVISED PLAT OF "THE GARDENS" IN THE VILLAGE OF FONTANA-ON-GENEVA-LAKE, WALWORTH CO. WISCONSIN

OCT. 1, 1940

Lloyd L. Jensen
H.C.J.

SURVEY No. 1087

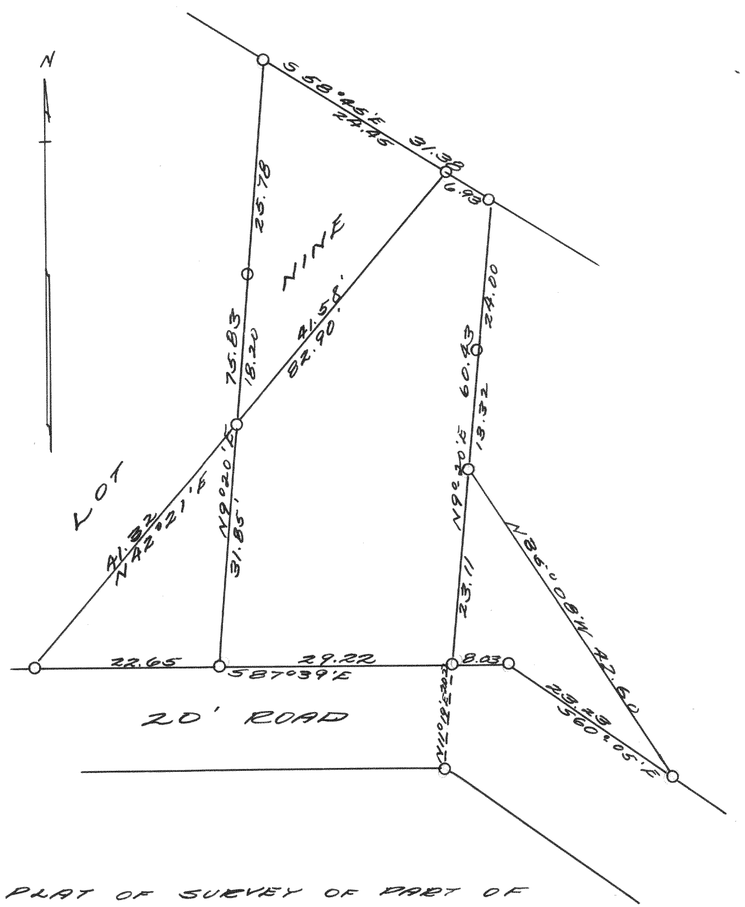

PLAT OF SURVEY OF PART OF LOT 9 AND ADJOINING LAND ALL IN "THE GARDENS" IN THE VILLAGE OF FONTANA-ON-GENEVA-LAKE, WALWORTH COUNTY, WISCONSIN.

SEPT., 1940

Lloyd L. Jensen
H.E.V.