
370


SURVEY NO. 1088

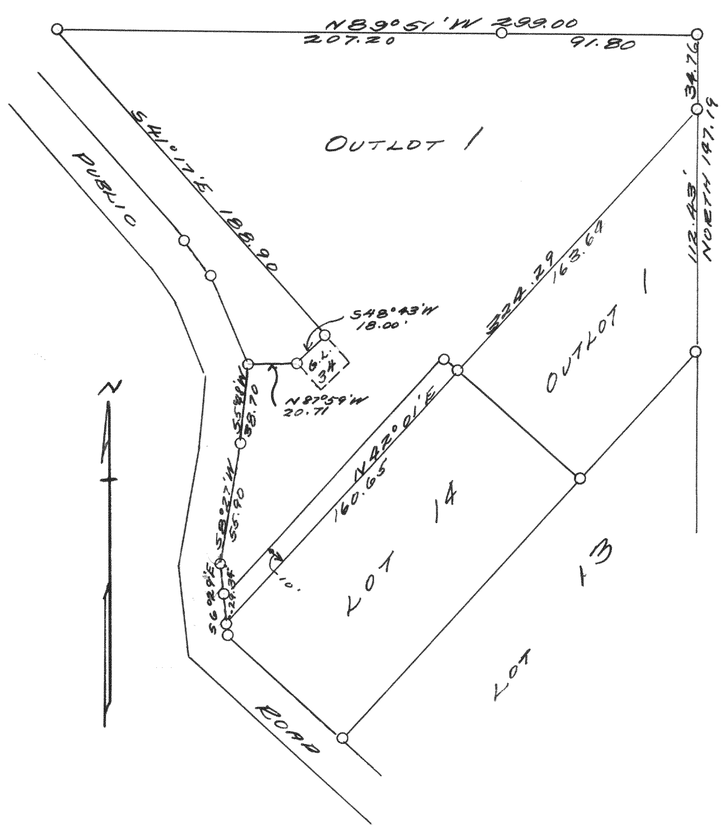

PLAT OF SURVEY OF GARAGE LOT 39, AND PART OF OUTLOT ONE AND PART OF LOT 14 OF THE REVISED PLAT OF THE GARDENS IN THE VILLAGE OF FONTANA-ON GENEVA LAKE, WALWORTH COUNTY, WISCONSIN.
APRIL 19, 1940

Lloyd L. Jensen
H.E.J.

SURVEY NO 1089

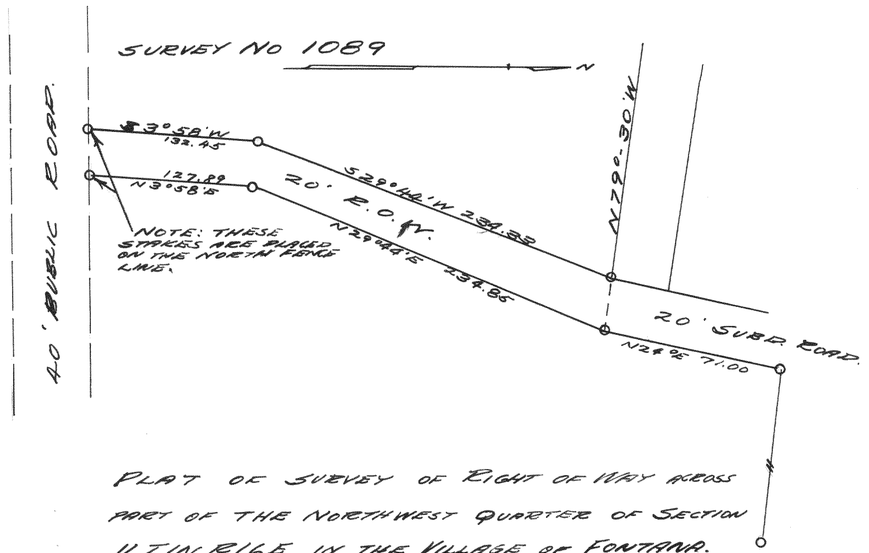

PLAT OF SURVEY OF RIGHT OF WAY ACROSS PART OF THE NORTHWEST QUARTER OF SECTION 11 T1N R16E, IN THE VILLAGE OF FONTANA.
OCT., 1940

Lloyd L. Jensen
H.E.J.

SURVEY NO. 1090



PLAT OF SURVEY OF ~~RIGHT OF WAY~~ LOT EIGHT OF BLOCK 19 OF GLENWOOD SPRINGS, IN THE VILLAGE OF FONTANA-ON-GENEVA LAKE
AUG. 1940

Lloyd L. Jensen
H.E.J.