

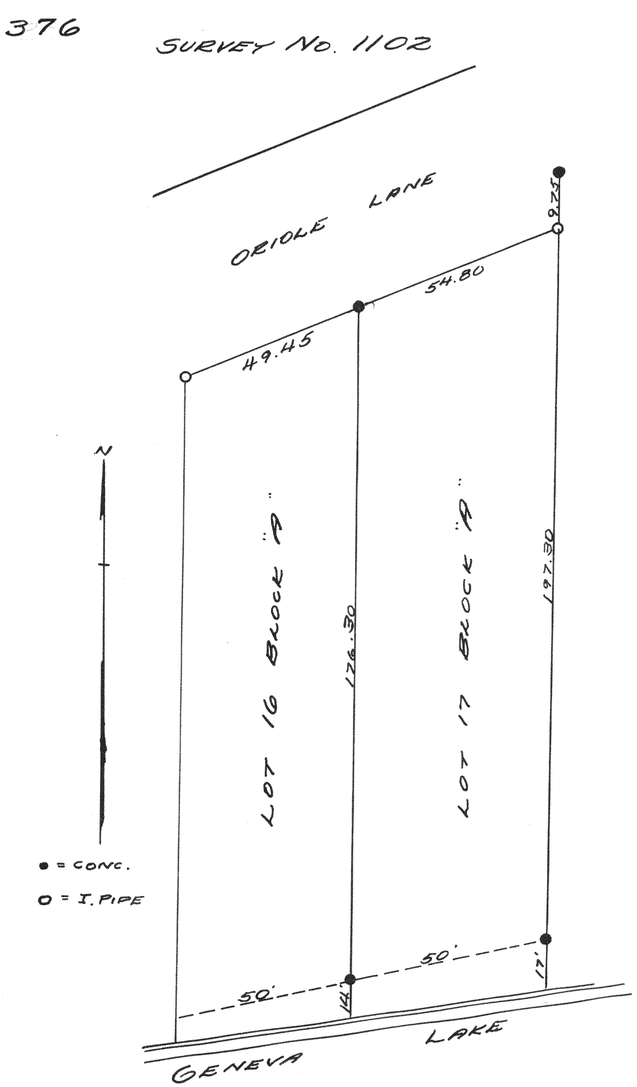


PLAT OF SURVEY OF LOT 17 BLK. "A" OF CISCO BEACH SUBDIVISION T1N R17E, WALWORTH COUNTY, WISCONSIN
MAY 27, 1940
Lloyd L. Jensen
W.E.J.

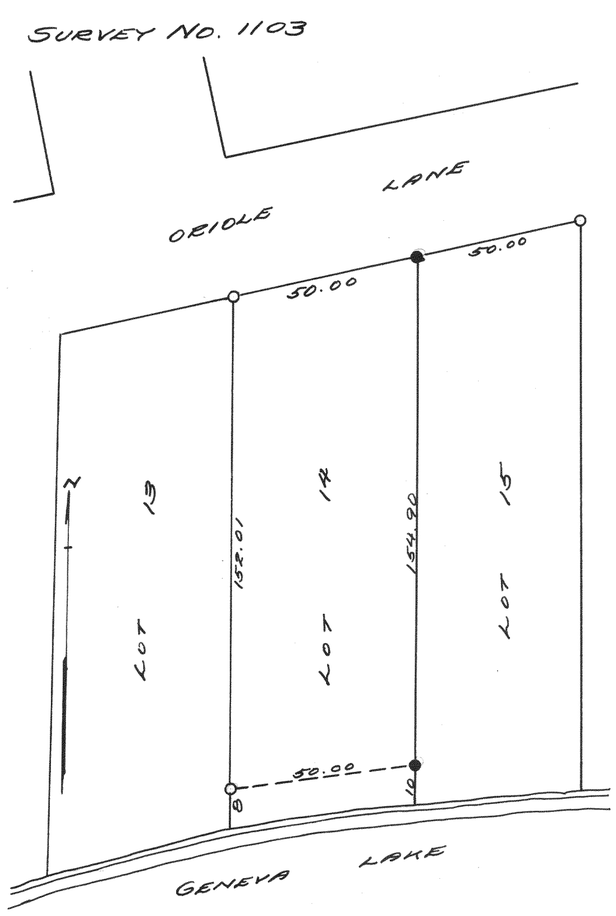

PLAT OF SURVEY OF LOT 14 OF BLOCK "A" OF CISCO BEACH SUBD. T1N R17E WALWORTH COUNTY
OCT., 1940
Lloyd L. Jensen
W.E.J.

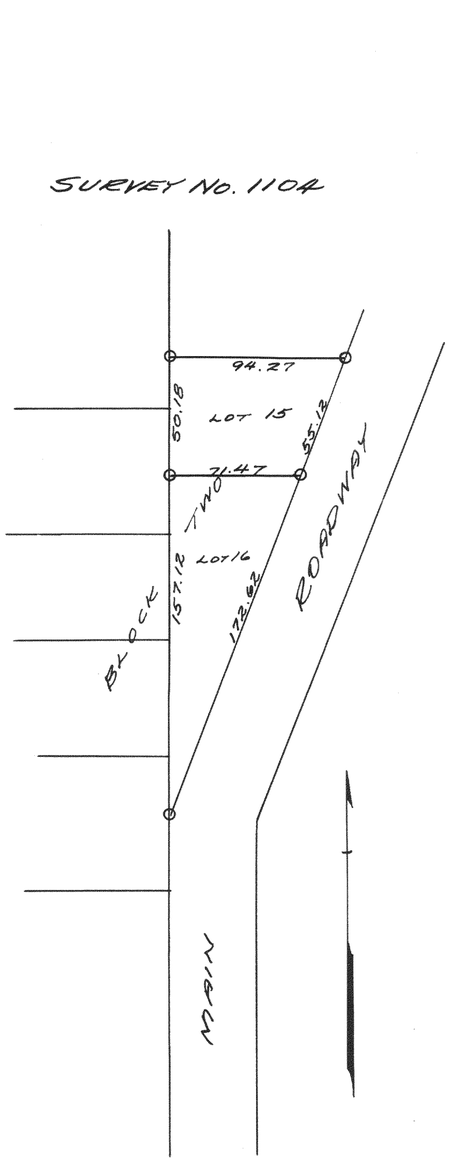

PLAT OF SURVEY OF LOTS 15 & 16 OF BLOCK 2 OF SUNSET HILLS SUBDIVISION
JAN. 1991
Lloyd L. Jensen
W.E.J.