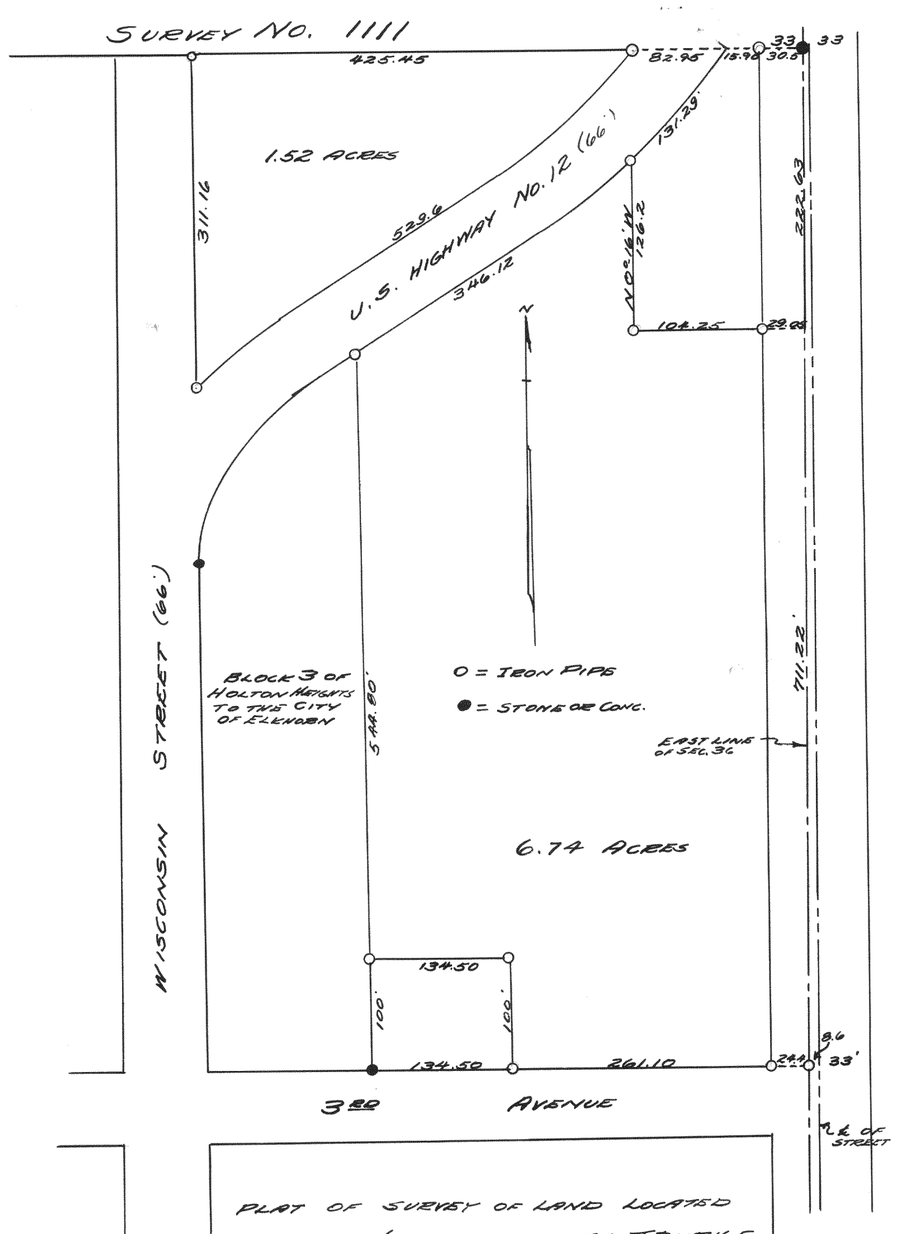

PLAT OF SURVEY OF LAND LOCATED IN THE NE¼ OF SECTION 36 T3NR16E CITY OF ELKHORN, WALWORTH CO. WISC.
OCT., 1940
Lloyd L. Jensen
H.E.J.

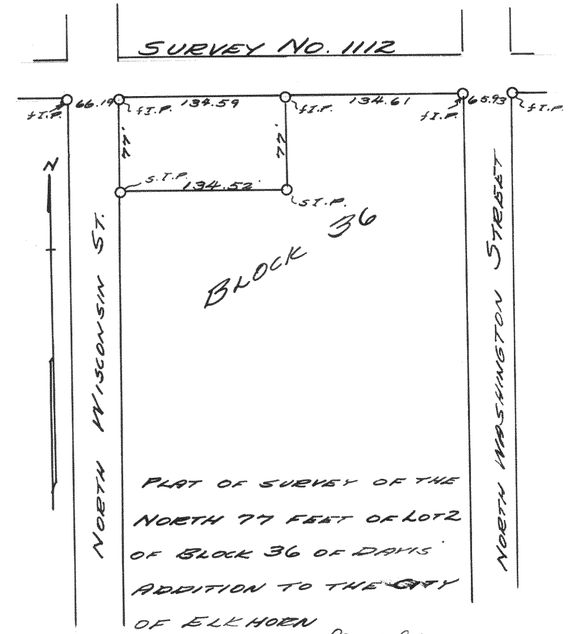

PLAT OF SURVEY OF THE NORTH 77 FEET OF LOT 2 OF BLOCK 36 OF DAVIS' ADDITION TO THE CITY OF ELKHORN
APRIL 1940
Lloyd L. Jensen

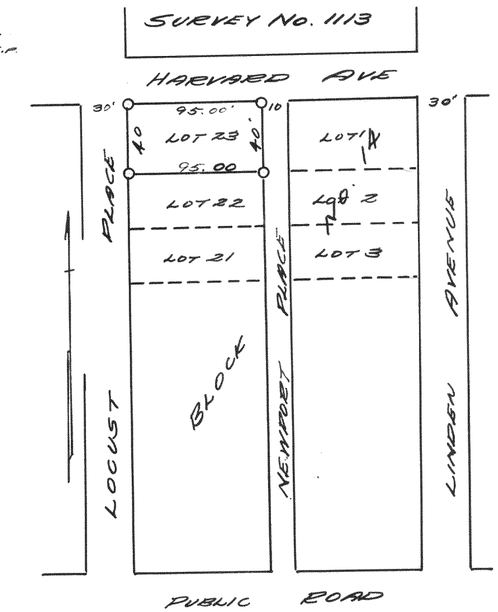

PLAT OF SURVEY OF LOT 23 BLOCK 19, OF GLENWOOD SPRINGS, FONTANA, WALWORTH COUNTY, WISCONSIN.
Lloyd L. Jensen

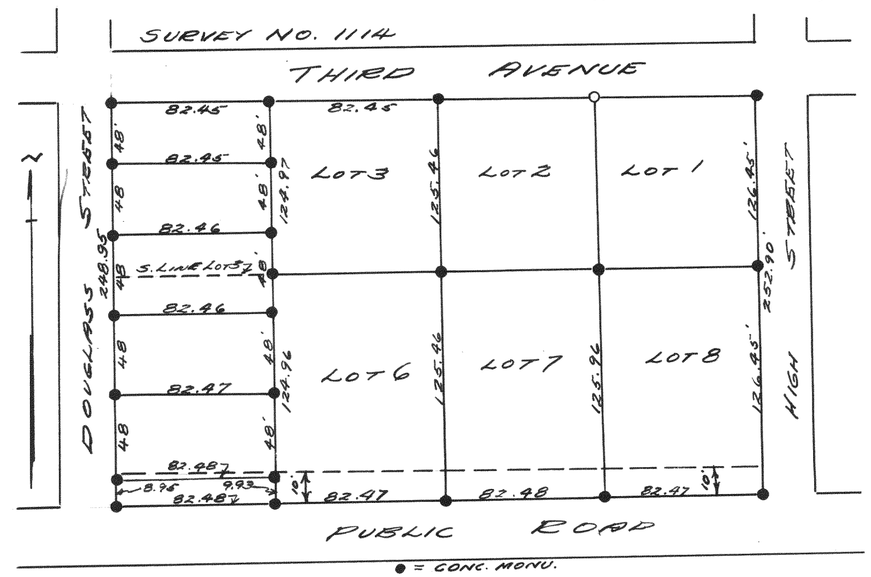

PLAT OF SURVEY OF LOTS 3, 4, 5, 6, 7 & 8 OF BLOCK 8 OF THE ORIGINAL VILLAGE OF FONTANA.
JULY 24, 1940
Lloyd L. Jensen
H.E.J.