Record of Survey.

No 106

F. W. Fowler & W. Shank 7-4-15


Township....., North of Range.....of 4 Principal Meridian as presented by the courses and distances on the following plat, and annexed field-notes of survey:

Established the center of the section at the point of intersection of STRAIGHT quarter lines.

Established all quarter-quarter corners upon the section boundary at proportional distances between known section and quarter section corners, according to the original field-notes of the Government survey.

Established all lost corners at proportionate distances between known corners, according to the original field notes of the Government survey.

Began at corner on E. of lane, S. along E of lane 2131 to cor., E 145. Then S. again on line of fence produced 794 feet to pt. 114 W. of corner, W from this point 706 corner S 13° 85, E 367 corner S 463 RR, E 348 line of lane fence produced. S. on this line 278 RR, N from this point 1362 to point, Being on the East line of lane produced. From place of beginning N 85°- 30' E. along line of fence 502 to corner N. on E. line 340. Then W 512 to point in line of fence 5,340 N. of beginning.

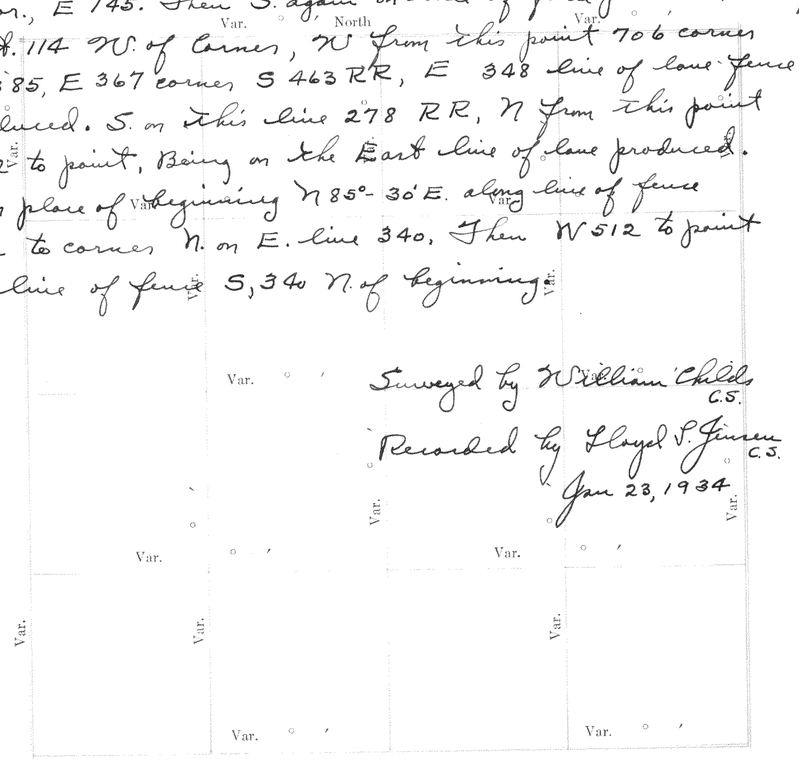

Surveyed by William Childs C.S.

Recorded by Lloyd S. Jensen C.S.

Jan 23, 1934

Plat of Section....., Township.....North, Range.....of 4 Principal Meridian Scale 80 chains to 6 inches. The figures in red ink are the lengths of the lines as stated in the field-notes of the Government survey.

Declination of the Magnetic Meridian from the True Meridian.....

Surveyed and sub-divided.....A. D. 1 , in accordance with the State Laws and Instructions of the Commissioner of the General Land office, and recorded on pages .....of Register in the County Clerk's office.

Witness my hand this.....day of.....A. D. 1

.....SURVEYOR.

DESCRIPTION

OF SECTION, QUARTER SECTION AND QUARTER QUARTER SECTION CORNERS

N. C. MILLER CO., MFG. STATIONERS, MILWAUKEE X15000

GOVERNMENT CORNERS	Bearing Trees	In. Dia.	Courses they bear	Links Distant	Bearing Trees	In. Dia.	Courses they bear	Links Distant	Bearing Trees	In. Dia.	Courses they bear	Links Distant	Bearing Trees	In. Dia.	Courses they bear	Links Distant
No.																
1. N. W. Sec. Cor. indentified,																
2. N. E. Sec. Cor. indentified,																
3. S. E. Sec. Cor. indentified,																
4. S. W. Sec. Cor. indentified,																
5. N. ¼ Sec. Cor. indentified,																
6. E. ¼ Sec. Cor. indentified,																
7. S. ¼ Sec. Cor. indentified,																
8. W. ¼ Sec. Cor. indentified,																
Subdivision Corners																
No.																
1. Center ¼ Sec. Cor.																
2. North ¼-⅛s N. W. qr.,																
3. East ¼-⅛s N. W. qr.,																
4. South ¼-⅛s N. W. qr.,																
5. West ¼-⅛s N. W. qr.,																
6. Center ¼-⅛s N. W. qr.,																
7. North ¼-⅛s N. E. qr.,																
8. East ¼-⅛s N. E. qr.,																
9. South ¼-⅛s N. E. qr.,																
10. Center ¼-⅛s N. E. qr.,																
11. East ¼-⅛s S. E. qr.,																
12. South ¼-⅛s S. E. qr.,																
13. West ¼-⅛s S. E. qr.,																
14. Center ¼-⅛s S. E. qr.,																
15. South ¼-⅛s S. W. qr.,																
16. West ¼-⅛s S. W. qr.,																
17. Center ¼-⅛s S. W. qr.																

No 107 C. K. Dunlap 9-2-17

At north Cor. post take 4 fences known to be right, S 2650 clear stake, 2652 fence west, 2622 from stake to S. qr. post. Fence post with trees right East 1335 center of road 2670 North 2612 center of road, 5284 corner, West 1321 fence 2646 N. qr. post. West 1324 fence post set by former survey, as ⅛ post, S. from this 2641 line of fence E & W 5264 fence clearing only 2623 for S half. From S W corner north 2627 to corner as fenced.

This gives the S. half 2612 to center of road on east line, 2620 on qr. line, 2623 on ⅛ line and 2627 on West line.

Surveyed by William Childs C.S.

Recorded by Lloyd S. Jensen C.S.

Jan 23, 1934

NAMES OF SWORN ASSISTANTS

CHAINMEN | FLAGMEN | AXMEN

No. 108 F. W. Fowler & W. Shank

7-4-15

At N. W. Cor. found old stake with stones around, 23' N. of nail in tree 31.5 from N. side of fence post and 6" E. of line of fence south, S. from this 2646 fence west for 1/4 cor., 2640 more cor., line from N. W. cor. over 1/4 post is 31'-9" E. of Cor. as fenced. East from SW and NW corners 2252 feet made points and ran line between. This point in Road is 393' W. of E. line

S. from center of road 100 4' is S. line of first piece 375 W. of corner and leaving 127 west to corner, 2134 more is S. line of second piece, 106 E of corner and 39' W. of corner, 783 more, line of third piece, 16 W. of corner & 835 E ← of (This line is N 89°10' W) 1362' S, line of section 800 E of SW Cor. of piece N & 433 E. of N.W. of Piece S., 5233 R.R., SW. along R.R. 488, W of S. piece is 463, N. end is 433.

N. peice is 393 on N, 1004 on W, 375 on S & 978 on E
Second peice is 127 on N, 2131 on W, 106 on S & 2134 on E
Third piece is 39 on N. 16 on S, 783
Fourth piece is 1362 on E, 835 on N, 1385 on W & 800 on S

Surveyed by William Childs C.S
Sept. 25, 1918
Recorded by Floyd S. Jensen C.S.
Jan. 23, 1934

No 109 15-1-16

Description of Thompson Survey.

All of that certain piece or parcel of land lying and being in the SW 1/4 of SW 1/4 of Sec. 15-1-16, Town of Walworth, Walworth County Wisconsin, and more fully described as follows to wit:-

Beginning at the NW corner of the said SW 1/4 of the SW 1/4 of said Sec. 15,

Thence east along the north line of said 1/4 1/4 section 538.3 feet.

Thence South parallel with the west line of said 1/4 1/4 section 526 feet.

Thence west parallel with the north line of said 1/4 1/4 section 538.3 feet to the West line of said 1/4 1/4 Sec.

Thence North on said west line 526 feet to the place of beginning containing 6.5 Acres of land.

Surveyed by William Childs C.S.

Recorded by Floyd S. Jensen C.S
Jan 23, 1934