

SURVEY NO. 1118

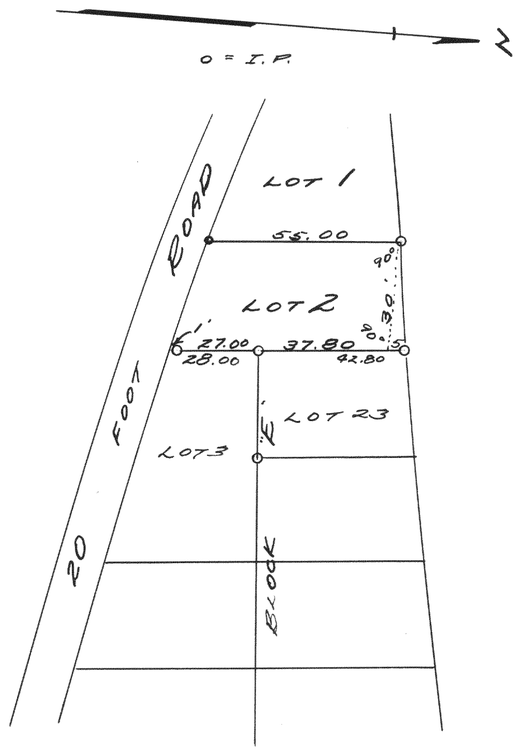

PLAT OF SURVEY OF LOT 2 OF BLOCK "E" OF DELAVAN LAKE ASSEMBLY PARK, WAL. CO. WISC.
SEPT 1940

Lloyd L Jensen
M.E.S.


SURVEY NO. 1120

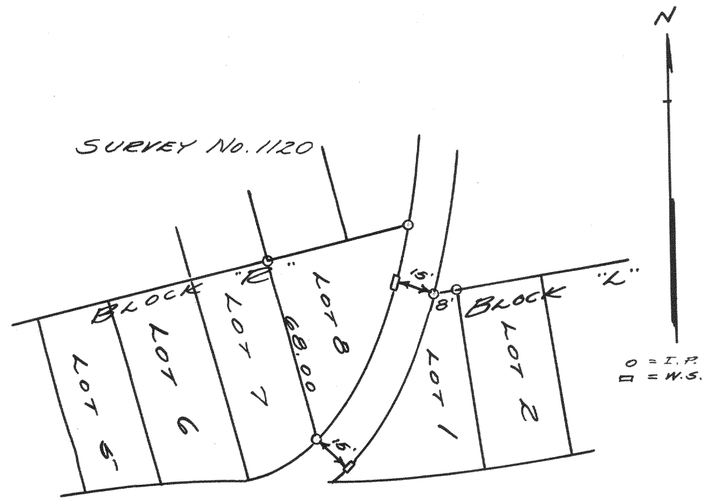

PLAT OF SURVEY OF 15' DRIVE BETWEEN LOT 1, BLOCK "L" AND LOT 8, BLOCK "E" OF DELAVAN LAKE ASSEMBLY PARK.
JULY 20, 1940

Lloyd L. Jensen
M.E.S.


SURVEY NO. 1121

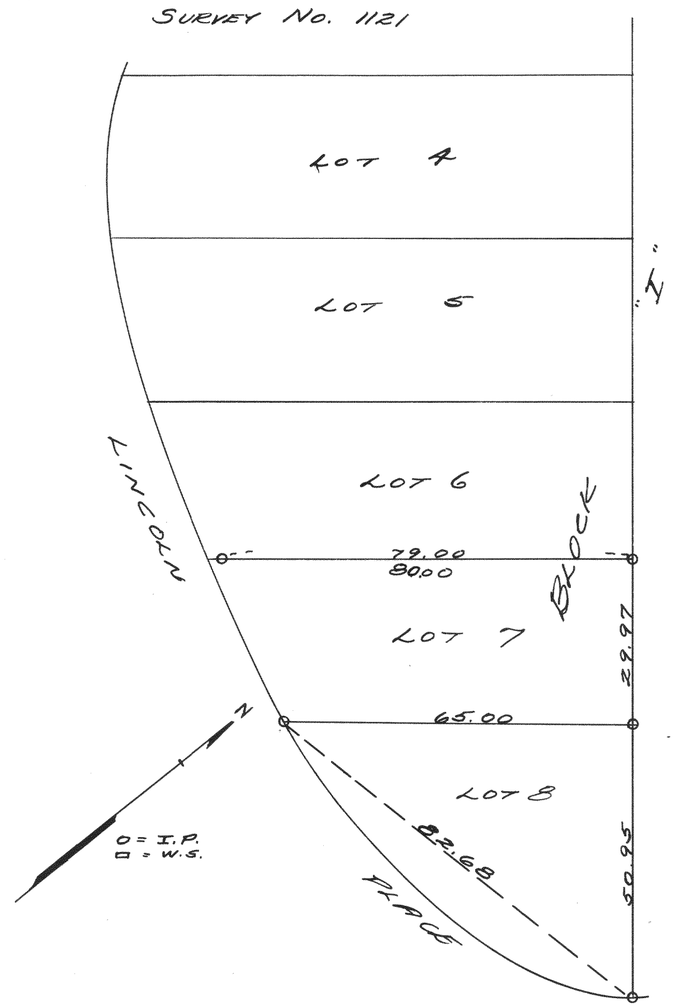

PLAT OF SURVEY OF LOTS 7&8 OF BLOCK "I", DELAVAN LAKE ASSEMBLY PARK, WAL. CO, WISC.
JULY 6, 1940

Lloyd L. Jensen
M.E.S.

SURVEY NO. 1119

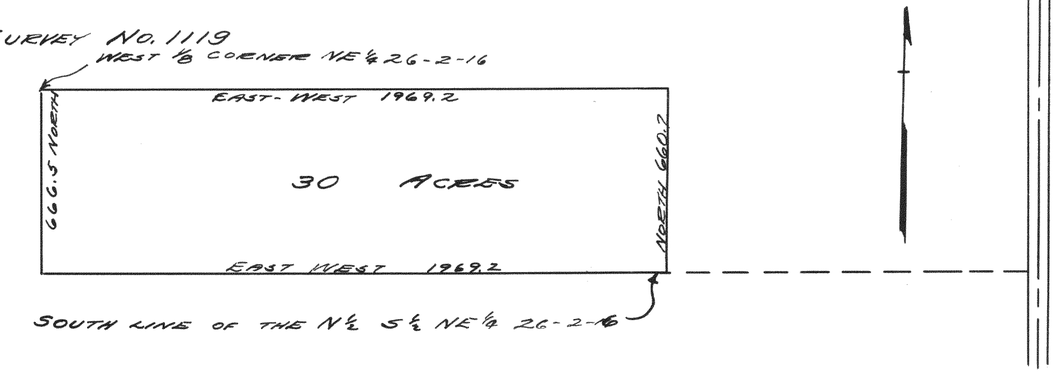

PLAT OF SURVEY OF THE WEST 1969.2 FEET OF THE NORTH ½ OF THE S½ NE¼, 26-2-16
1940

Lloyd L Jensen
M.E.S.