
384


## SURVEY NO. 1126

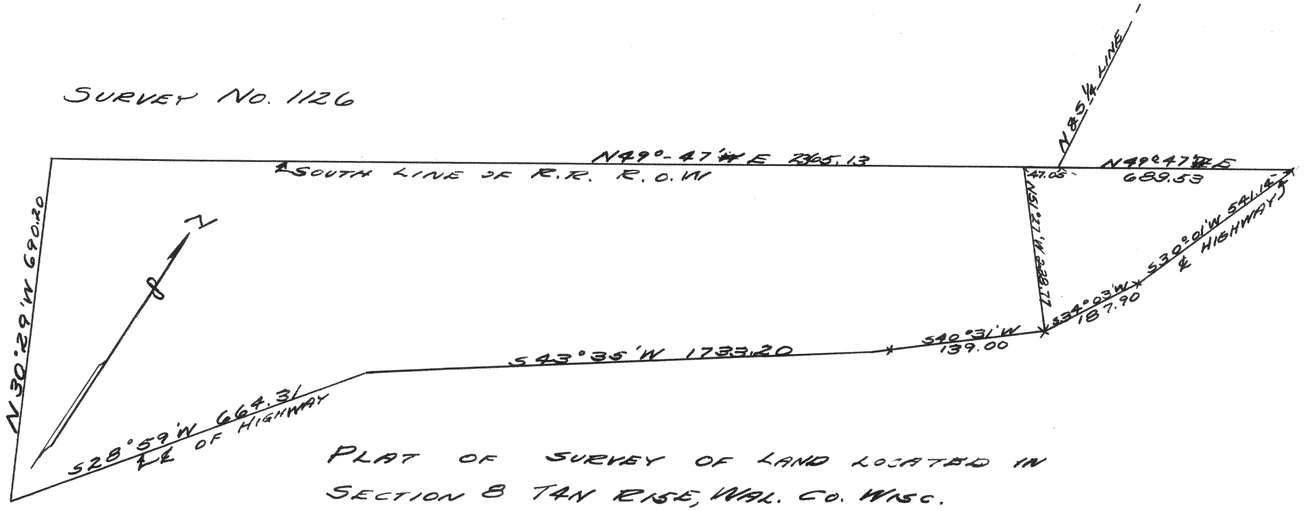


PLAT OF SURVEY OF LAND LOCATED IN SECTION 8 TAN RISE, WAL. CO. WISC.
MARCH 1940

Lloyd L. Jensen
H.E.J.


## SURVEY NO. 1127

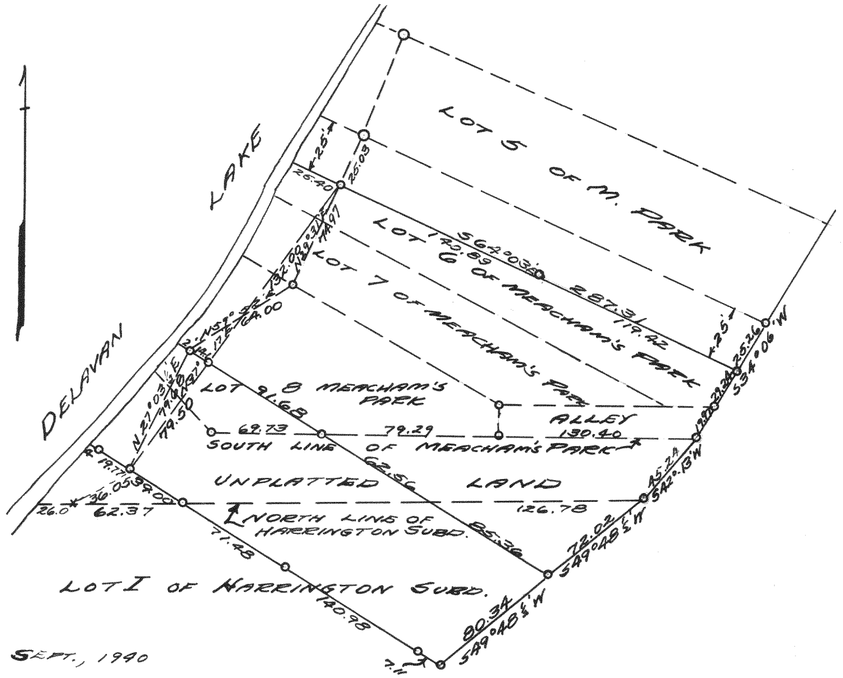


PLAT OF SURVEY OF PART OF LOTS 6 & 8, ALL OF LOT 7, & THE ALLEY, AND PART OF LOT I OF HARRINGTONS SUBD. & UNPLATTED LAND ALL IN NE. FR. ¼ 27-2-16

Lloyd L. Jensen

## SURVEY NO. 1128

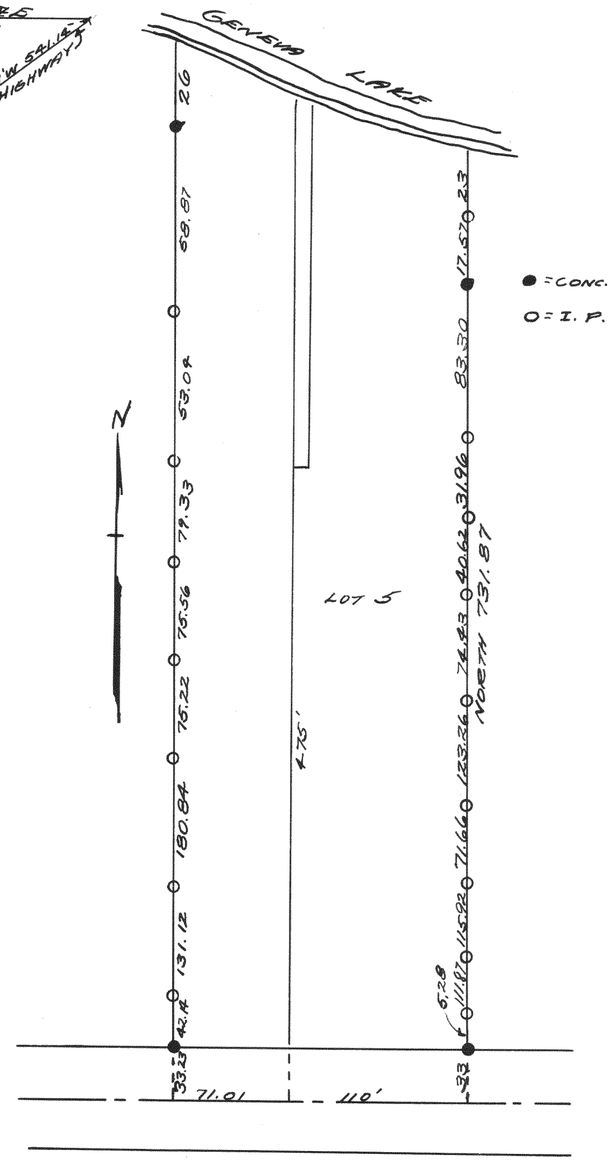


PLAT OF SURVEY OF LOT 5 OF ROBERT GARDNER'S SUBD. AND OF ADJOINING LAND ALL IN SECTION 13 - 1 - 16, WAL. CO. WISC.
FEB. 1940

Lloyd L. Jensen