
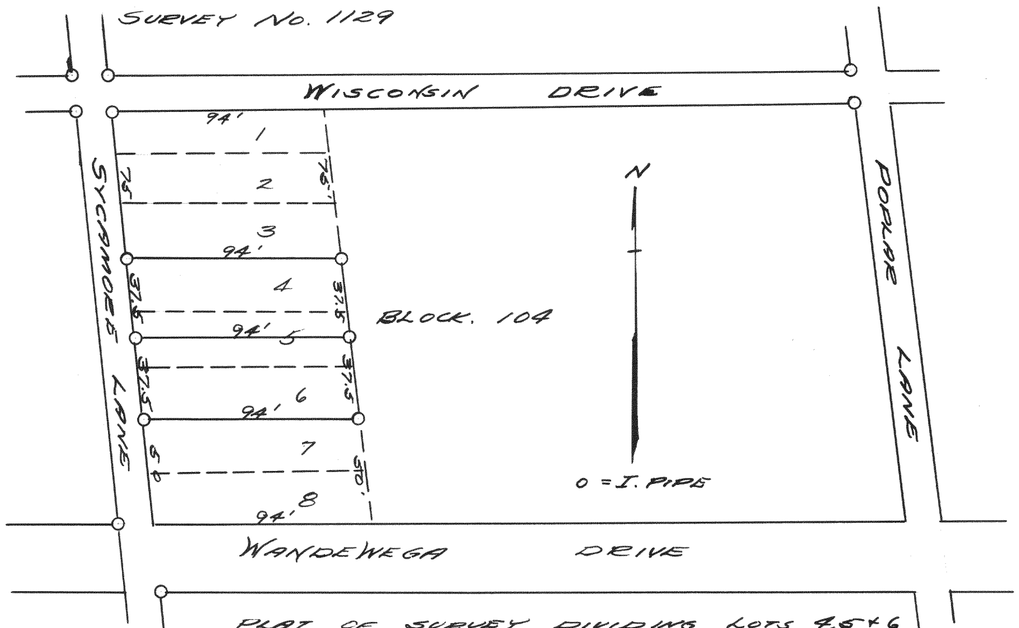


PLAT OF SURVEY DIVIDING LOTS 4,5+6 OF BLOCK 104 OF LAKE WANDEMEGA SUBD. AUG. 1940

Lloyd L. Jensen H.E.

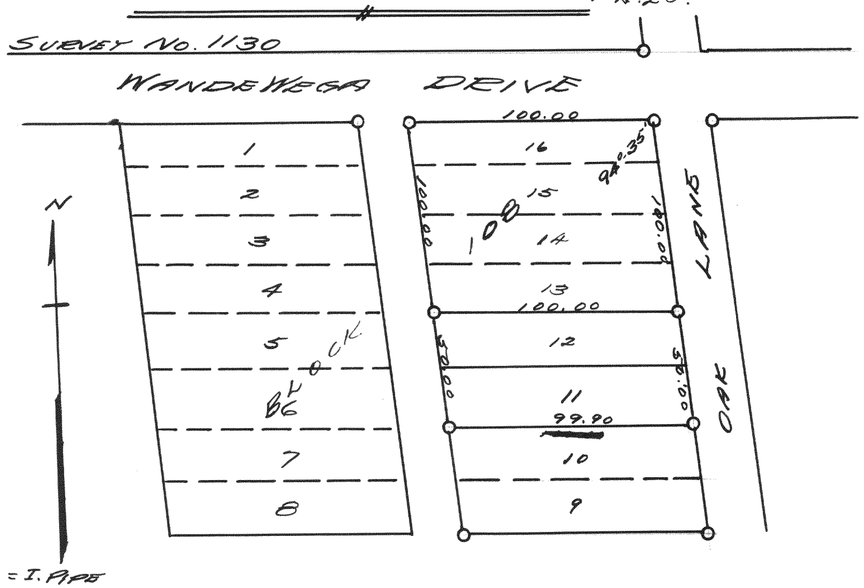


PLAT OF SURVEY OF LOTS 11+12 OF BLOCK 108 OF LAKE WANDEMEGA SUBD.

SEPT. 1940

Lloyd L. Jensen H.E.

SUEVEY No. 1131

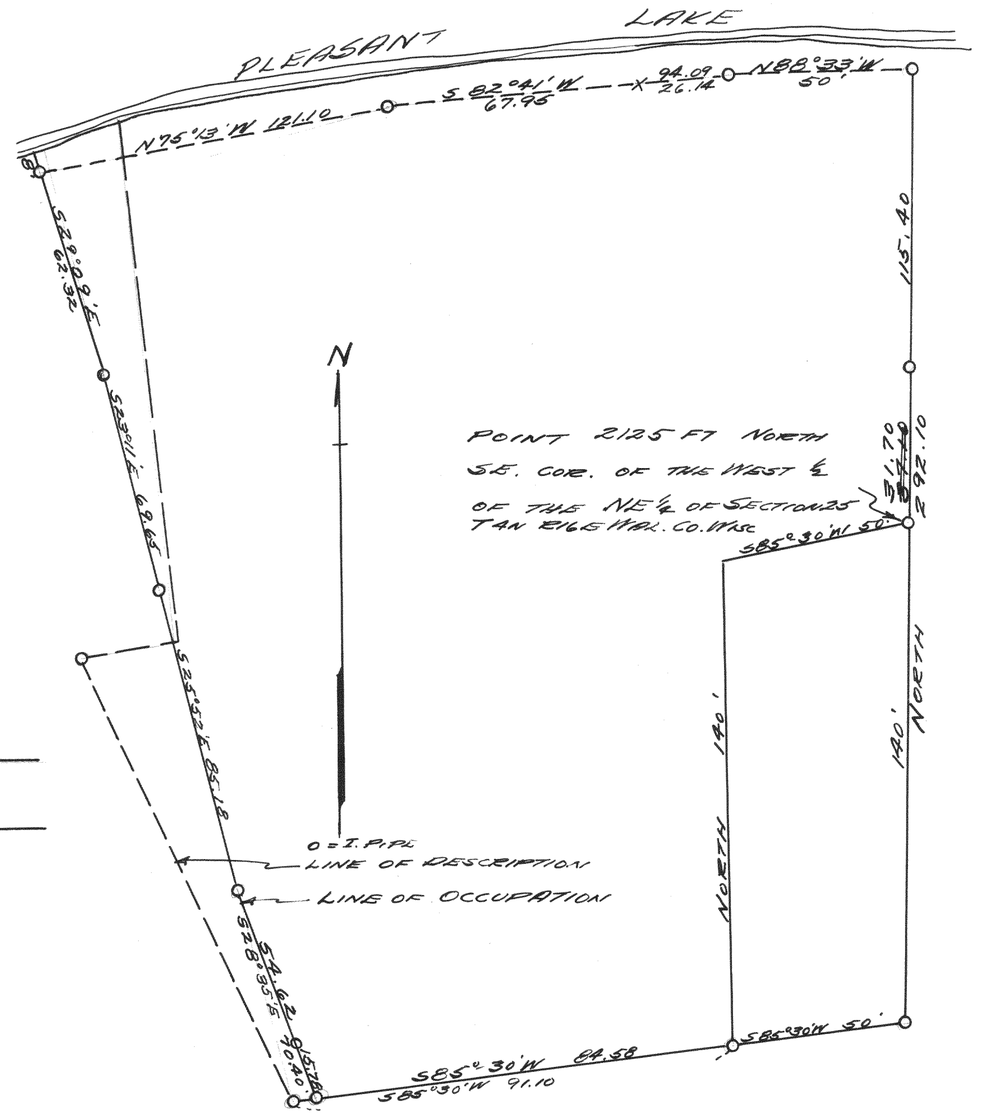

PLAT OF SURVEY OF LAND IN THE NE¼ 25-4-16

1940

Lloyd L. Jensen H.E.