
388

SURVEY NO. 1139

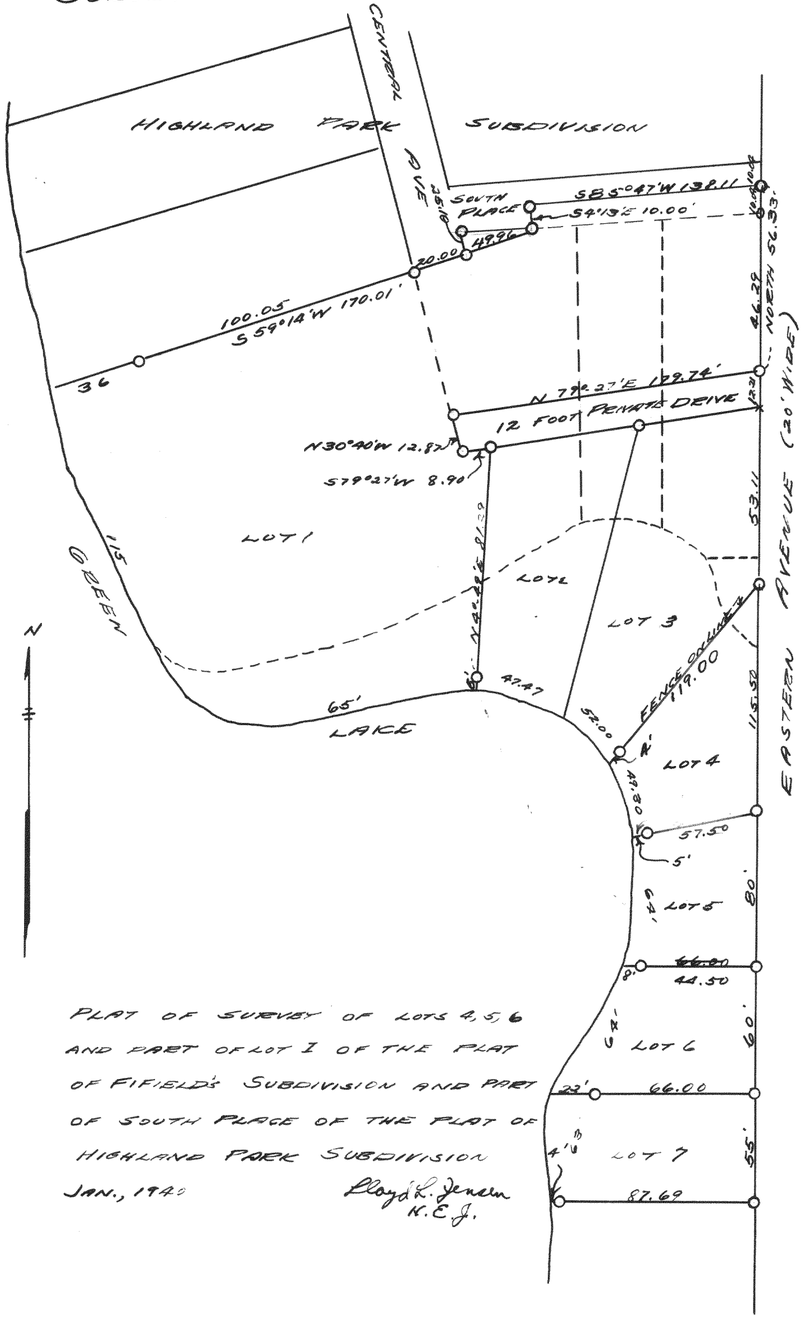


PLAT OF SURVEY OF LOTS 4, 5, 6 AND PART OF LOT 1 OF THE PLAT OF FIFIELD'S SUBDIVISION AND PART OF SOUTH PLACE OF THE PLAT OF HIGHLAND PARK SUBDIVISION

JAN., 1940

Lloyd L. Jensen
K.E.J.

SURVEY NO. 1140

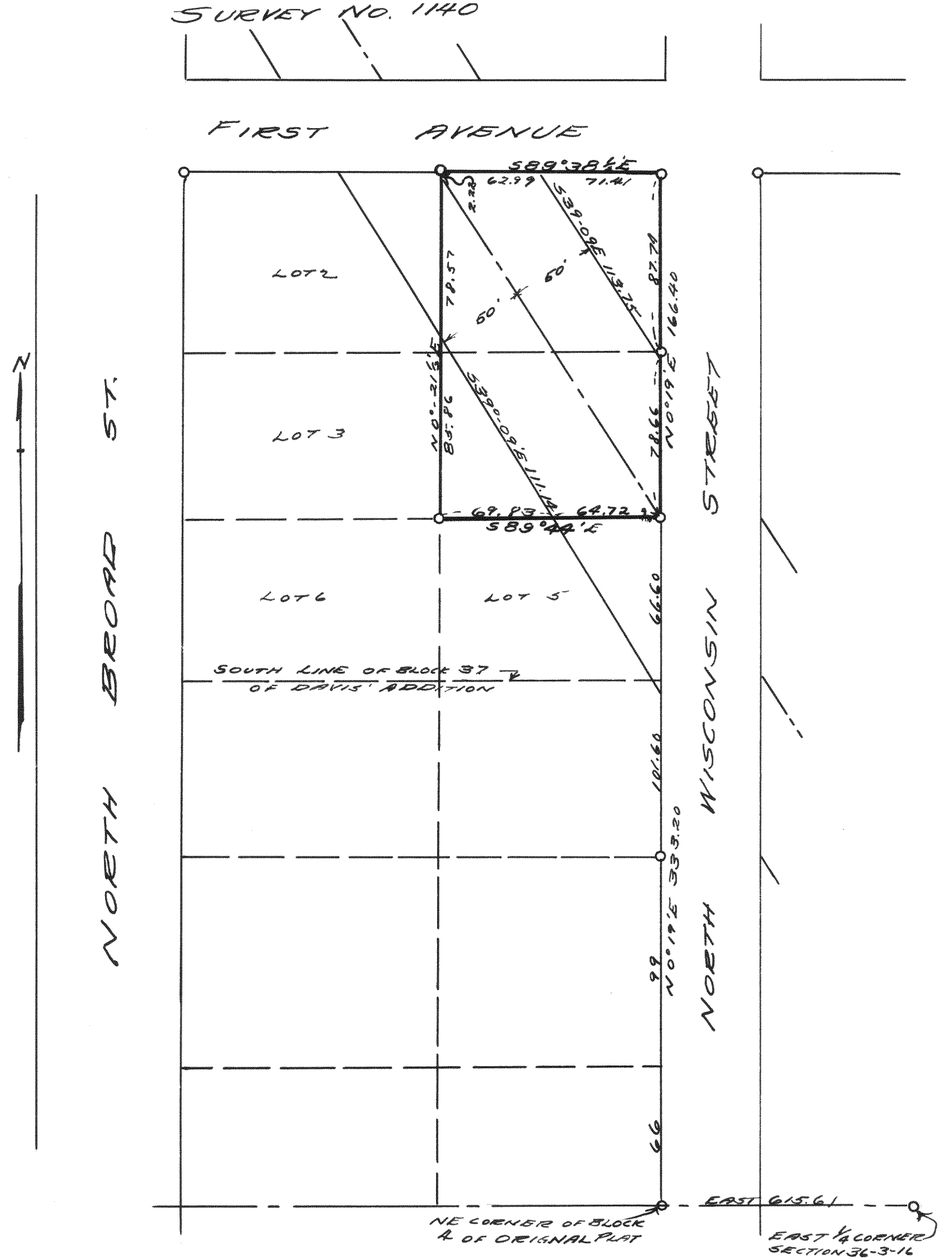

PLAT OF SUBUEY OF PART OF BLOCK 37 OF DAVIS' ADDITION TO THE CITY OF ELKHORN

FEB. 1940

Lloyd L. Jensen
K.E.J.