
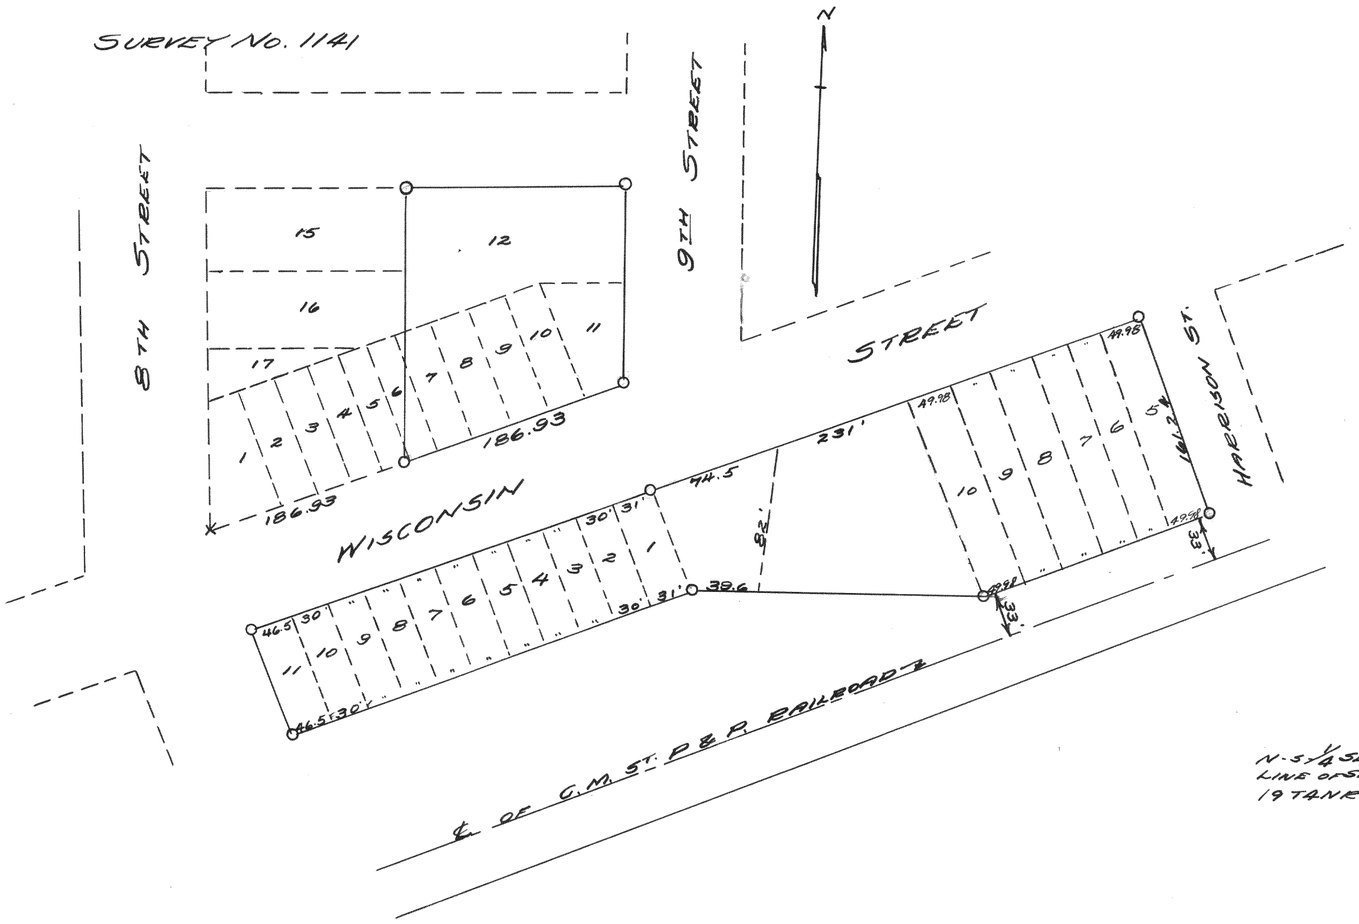


PLAT OF SURVEY OF BRADLEY KNITTING MILL IN THE CITY OF DELAVAN, WALWORTH COUNTY, WISCONSIN.
MAY 18, 1940
Lloyd L. Jensen
R.E.J.

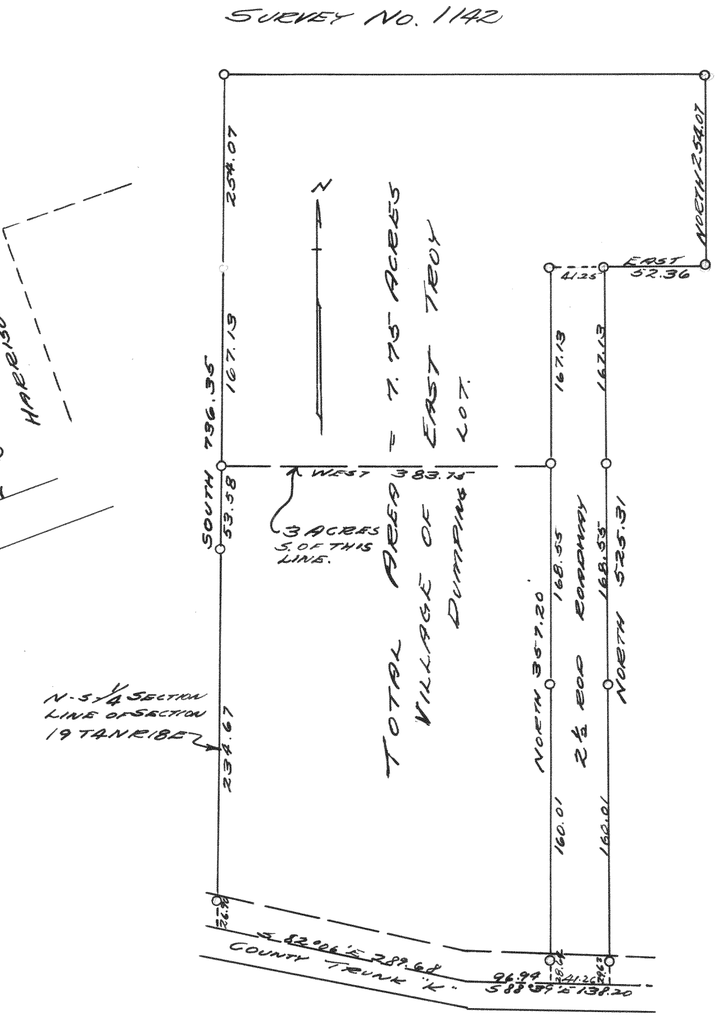

PLAT OF SURVEY OF LAND IN THE EAST HALF OF SECTION 19 T4N R18E, WALWORTH COUNTY WISCONSIN
FEB. 12, 1941
Lloyd L. Jensen
R.E.J.