
394


SURVEY NO. 1155

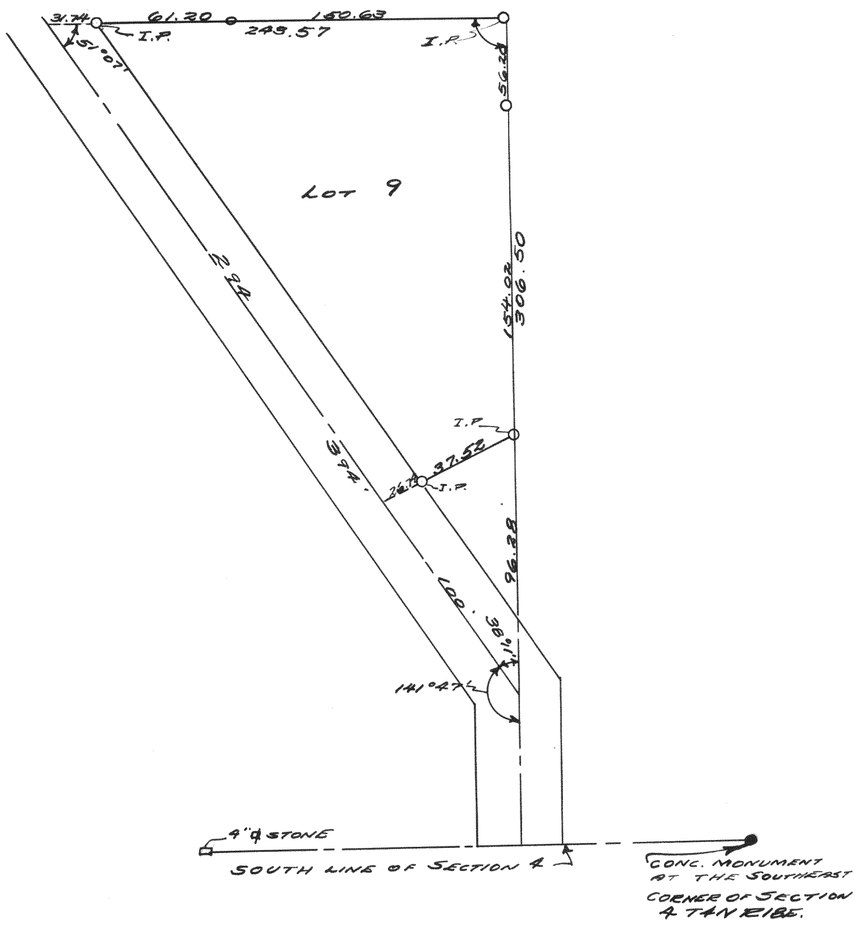

PLAT OF SURVEY OF PART OF LOT 9 OF BEULAH LAKE PARK.

AUG. 1940 Lloyd L. Jensen R.E.S.


SURVEY NO. 1156

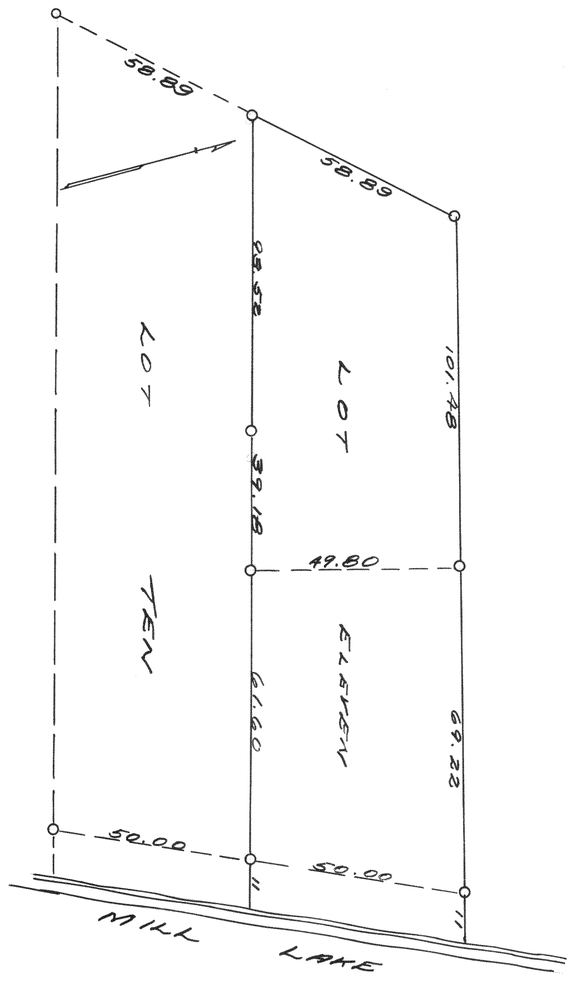

PLAT OF SURVEY OF LOT 11 OF MILLSITE SUBDIVISION, A SUBDIVISION LOCATED IN SECTION 4 TAN R18E

JULY 27, 1940 Lloyd L Jensen R.E.S.

SURVEY NO. 1157

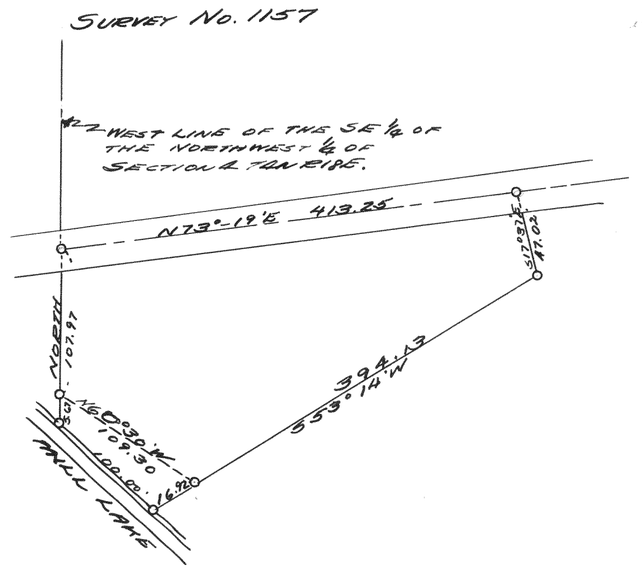

PLAT OF SURVEY OF A PARCEL OF LAND LOCATED IN THE SE¼ OF THE NORTHWEST¼ OF SECTION 4 TAN R18E, WALWORTH CO. WISC.

JULY 15, 1940 Lloyd L Jensen R.E.S.