

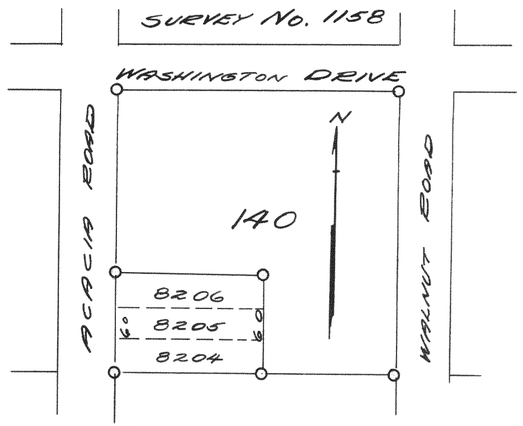


PLAT OF SURVEY OF LOTS 8204 TO 8206 OF LAKE COMO BEACH SUBD.
JULY, 1940 Lloyd L. Jensen R.E.S.

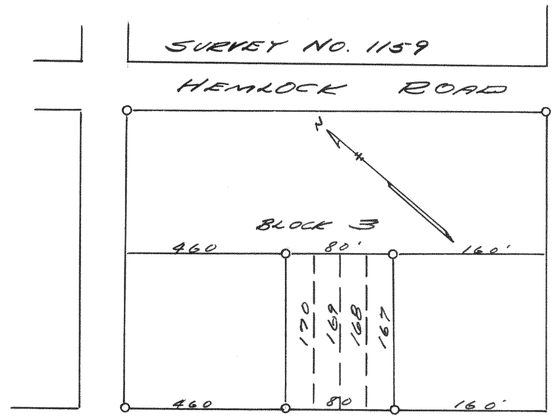


U. S. HIGHWAY No. 12.

PLAT OF SURVEY OF LOTS 167, 168, 169 & 170 OF BLOCK 3 OF SECTION ONE OF PELL LAKE SUBDIVISION
NOV. 1939 Lloyd L. Jensen R.E.S.

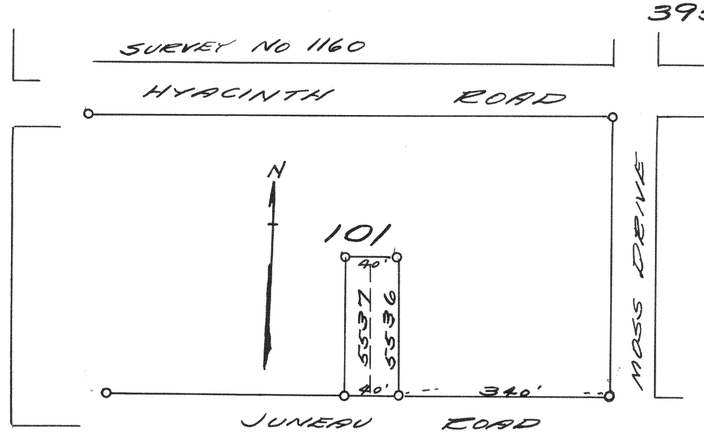


PLAT OF SURVEY OF LOTS 5236 & 5237 OF BLOCK 101 OF PELL LAKE SUBD.
JULY 1940 Lloyd L. Jensen R.E.S.

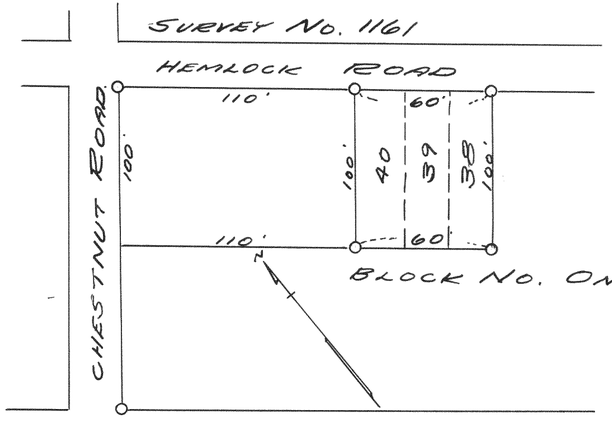


U. S. HIGHWAY NO. 12

PLAT OF SURVEY OF LOTS 38, 39 & 40 OF BLOCK 1 OF SECTION 1 OF BELL LAKE SUBDIVISION, WAK. CO. WISC.
NOV. 1939 Lloyd L. Jensen R.E.S.

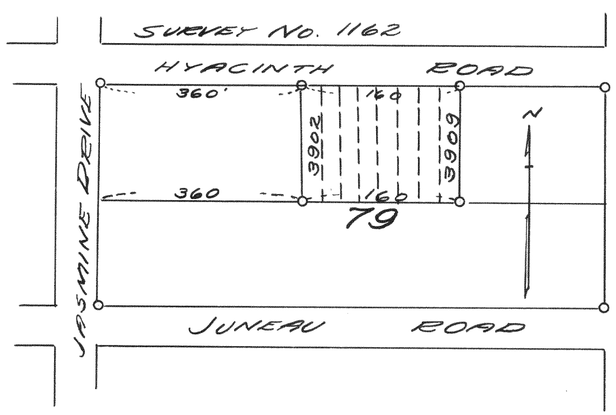

PLAT OF SURVEY OF LOTS 3902 TO 3909 OF SECTION 3 OF PELL LAKE SUBDIVISION, WALWORTH COUNTY, WISC.
JULY 2, 1940 Lloyd L. Jensen R.E.S.

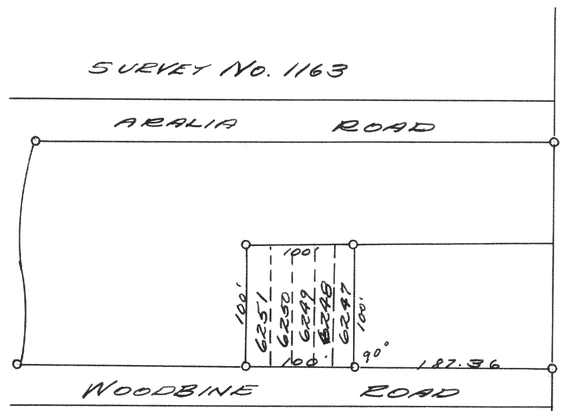

PLAT OF SURVEY OF LOTS 6247 TO 6251 OF SECTION 4 OF PELL LAKE SUBDIVISION
JULY, 1940 Lloyd L. Jensen R.E.S.