
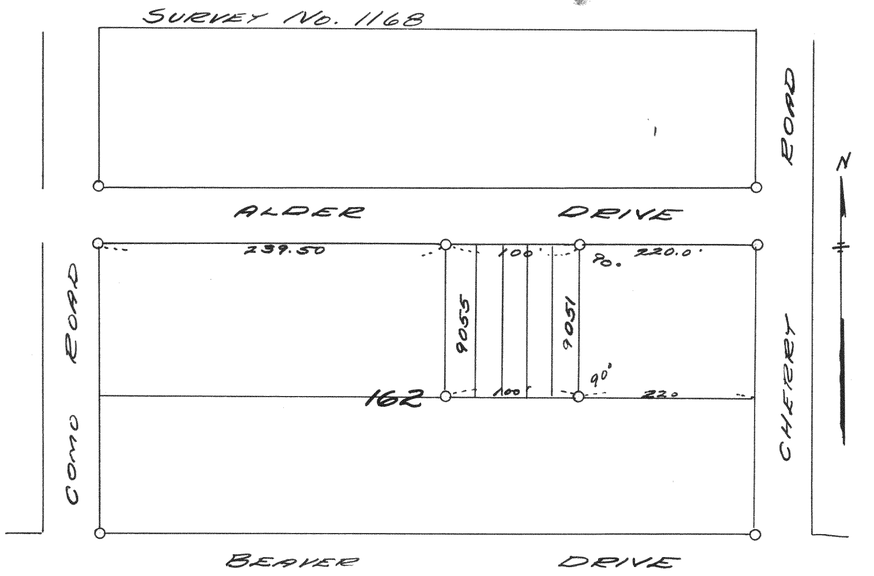



AUG. 12, 1940


Lloyd L. Jensen
N.E.J.

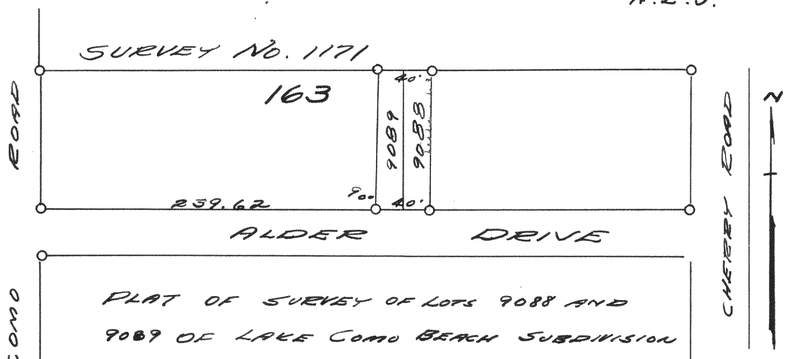

PLAT OF SURVEY OF LOTS 9088 AND 9089 OF LAKE COMO BEACH SUBDIVISION WALWORTH COUNTY, WISCONSIN

AUG. 12, 1940


Lloyd L. Jensen
N.E.J.

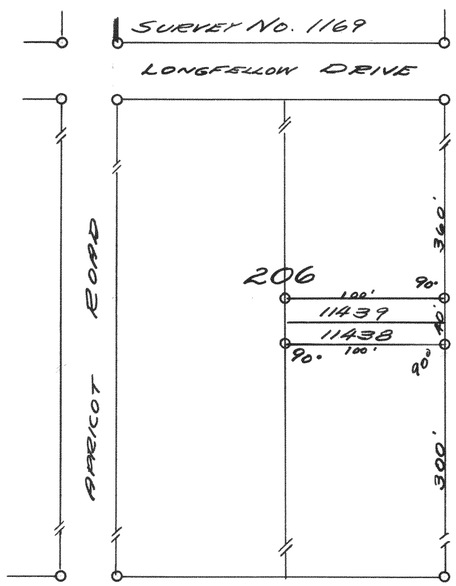

PLAT OF SURVEY OF LOTS 11438 AND 11439 OF LAKE COMO BEACH SUBDIVISION.

JULY 3, 1940


Lloyd L. Jensen
N.E.J.

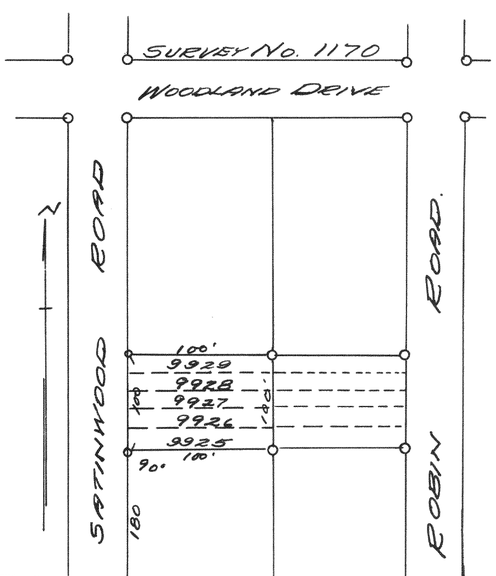


1940

Lloyd Jensen
N.E.J.

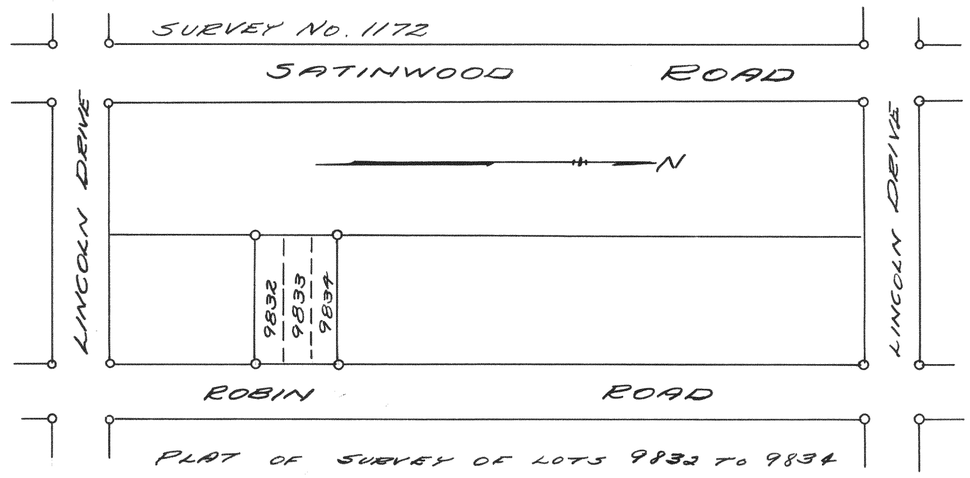

PLAT OF SURVEY OF LOTS 9832 TO 9834 OF LAKE COMO BEACH, WALWORTH CO, WISC.

JULY 31, 1940

Lloyd L. Jensen
N.E.J.