Record of Survey.

No 135

Township ..... North of Range 22 + 15 - 1 - 16 of 4 Principal Meridian

as presented by the courses and distances on the following plat and annexed field-notes of survey:


Established the center of the section at the point of intersection of straight quarter lines.

Established all quarter-quarter corners upon the section boundary at proportional distances between known section and quarter section corners, according to the original field-notes of the Government survey.

Established all lost corners at proportional distances between known corners according to the original field-notes of the Government survey.

Carl Schwabe

From corner of Church lot 330 make point this point is 64 + 724.5 + 330 = 1118.5 N of RR & Trans this point E 1441 to stone Rods E of gr. post & 12.11 more to stone for ¼ corner N. on stone thence from N. 16 E. line and 3147.5 more fence. Transit line run goes over stone and is 11.5 W. of stone at R.R. and is 1436 E. of N.W. corner. Ran line on 15 offset E. of NW. corner and first mentioned point. This line at RR is 8 E. of corner, angle at RR is 69°-30' This shortens R.R. line 8.5E along RR from corner to line from N 1537 + 11.5 = 1548.5 distance from corner to stone in road.

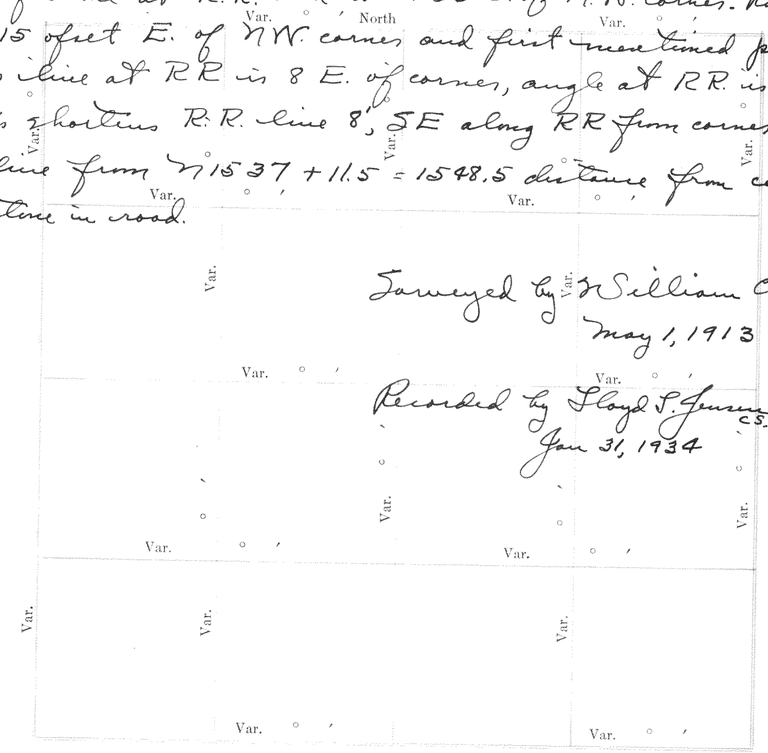
Var.
North
Var.
Var.
Var.

no 137

Walworth Village


Houston Oil Co.

Beginning at the ¼ sec. corner on the W. line of said Sec. 22, Thence E. on the ¼ Sec. line 90.5 ft. to a point Thence S 33.5 ft. to an iron stake, at the S. line of Cement walk and 96.5 ft. to an iron stake, Thence E. 11 ft. to an iron stake, Thence S 44 ft. Then W 64.3 ft. to the E. line of the Cement walk, and 99.3 ft. to the N ¼ Sec. line, Thence N. on the said ¼ Sec. line 142 ft. to the place of beginning; said grantors reserving for themselves their heirs executors, and assigns, the use of the driveway as it now exists at the present time, as the S side of the real estate herein conveyed, for all purposes of passing to and from all lands of said grantors heretofore reached by said driveway, until such time as a public street or alley shall be provided as laid out by the village of Walworth, which shall communicate with the said lands of said grantors.

William Child
C.S.

Recorded by Lloyd F. Jensen C.S.
Feb. 1, 1934

no 138

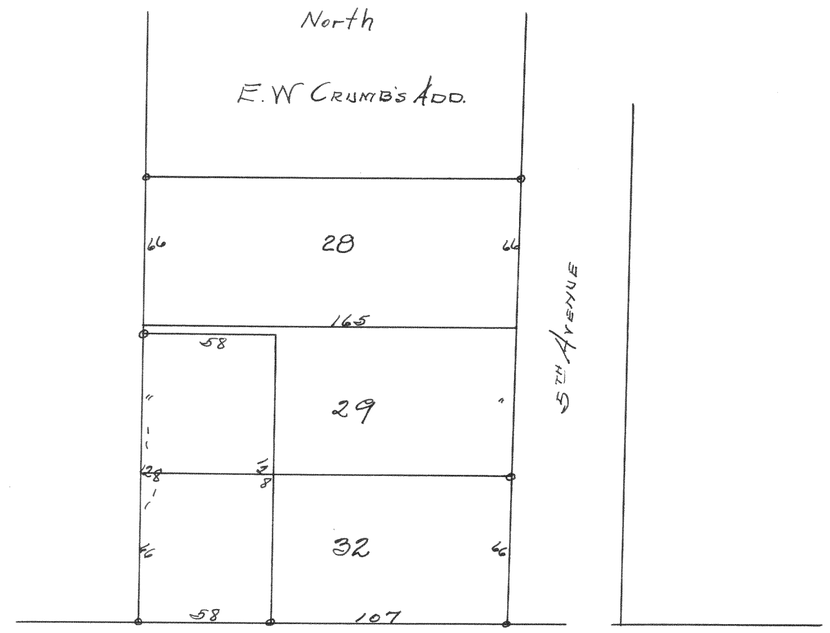

William Child
C.S.

Recorded by Lloyd F. Jensen C.S.
Feb. 1, 1934