Record of Survey.

No 139

W.m Pohlman

Township....., North of Range.....of 4 Principal Meridian as presented by the courses and distances on the following plat, and annexed field-notes of survey:

Established the center of the section at the point of intersection of STRAIGHT quarter lines.

Established all quarter-quarter corners upon the section boundary at proportional distances between known section and quarter section corners, according to the original field-notes of the Government survey.

Established all lost corners at proportionate distances between known corners, according to the original field notes of the Government survey.

From ¼ post 33 N W 33 ∞ is 21.5" East of ream in walk. W 494.4 is west side of cross walk and is 15" W. of west of walk.

S 38 rods = 627 - 494.4 = 132.6, 132.6 W. of these 2 points set stakes for 38 rod line. The South line was taken from line of recorded plat of Phillips Add.

Set stakes for 4 - 3 3/2 Rod = 60.5 feet from this line.

Surveyed by William Childs CS. Sept. 8. 19, 1921

Recorded by Lloyd S. Jensen CS. Feb. 1, 1934

Var. ° ′

Var. Var. Var. Var. Var. Var. Var. Var. Var. Var. Var. Var. Var. Var. Var. Var. Var.

Plat of Section....., Township.....North, Range.....of 4 Principal Meridian Scale 80 chains to 6 inches. The figures in red ink are the lengths of the lines as stated in the field-notes of the Government survey.

Declination of the Magnetic Meridian from the True Meridian.....

Surveyed and sub-divided.....A. D. 1 , in accordance with the State Laws and Instructions of the Commissioner of the General Land office, and recorded on pages .....of Register in the County Clerk's office.

Witness my hand this.....day of.....A. D. 1

.....SURVEYOR.


DESCRIPTION

OF SECTION, QUARTER SECTION AND QUARTER QUARTER SECTION CORNERS

H. C. MILLER CO., MFG. STATIONERS, MILWAUKEE X15000

GOVERNMENT CORNERS	Bearing Trees	In. Dia.	Courses they bear	Links Distant	Bearing Trees	In. Dia.	Courses they bear	Links Distant	Bearing Trees	In. Dia.	Courses they bear	Links Distant	Bearing Trees	In. Dia.	Courses they bear	Links Distant
No.																
1. N. W. Sec. Cor. indentified,																
2. N. E. Sec. Cor. indentified,																
3. S. E. Sec. Cor. indentified,																
4. S. W. Sec. Cor. indentified,																
5. N. ¼ Sec. Cor. indentified,																
6. E. ¼ Sec. Cor. indentified,																
7. S. ¼ Sec. Cor. indentified,																
8. W. ¼ Sec. Cor. indentified,																
Subdivision Corners																
No.																
1. Center ¼ Sec. Cor.																
2. North ¼-¼s N. W. qr.,																
3. East ¼-¼s N. W. qr.,																
4. South ¼-¼s N. W. qr.,																
5. West ¼-¼s N. W. qr.,																
6. Center ¼-¼s N. W. qr.,																
7. North ¼-¼s N. E. qr.,																
8. East ¼-¼s N. E. qr.,																
9. South ¼-¼s N. E. qr.,																
10. Center ¼-¼s N. E. qr.,																
11. East ¼-¼s S. E. qr.,																
12. South ¼-¼s S. E. qr.,																
13. West ¼-¼s S. E. qr.,																
14. Center ¼-¼s S. E. qr.,																
15. South ¼-¼s S. W. qr.,																
16. West ¼-¼s S. W. qr.,																
17. Center ¼-¼s S. W. qr.																

No 140

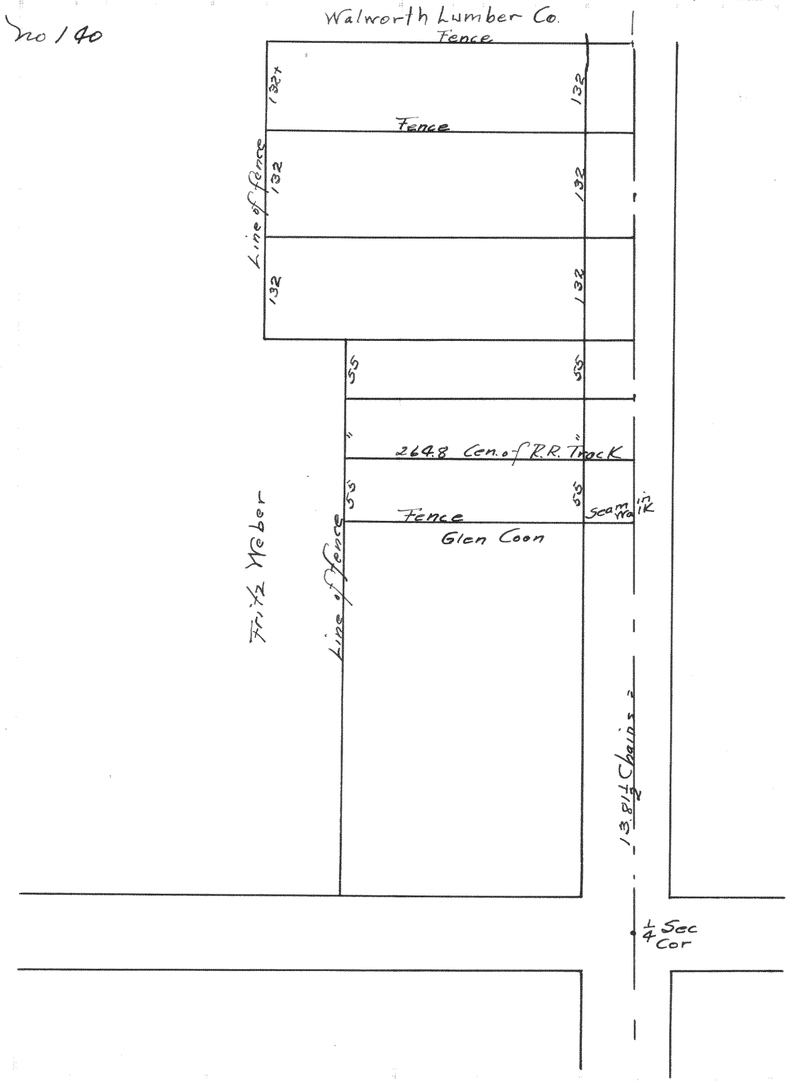

CHAINMEN

NAMES OF SWORN ASSISTANTS

FLAGMEN

Surveyed by William Child CS

Recorded by Lloyd S. Jensen CS. Feb. 1, 1934

No 141

All of That certain piece or parcel of land, ~~lying~~ and being in The Village of Walworth, Walworth County, Wisconsin, and being a part of The Plat of Colburns Sub-division, in The said Village, which Plat is on record in The Register of Deeds Office, in and for The said County, in Volume 5 of Plats, on Page 181, and a part also, of The Plat of Rolo's Addition to The said Village, which Plat is on Record in The said Register's Office, in Volume 4 of Plats on page 32, and being more fully described as follows, to wit:— Beginning at a point, on The West line of Lot No. 4 of The said subdivision, 36 feet North of The South west Corner Thereof. Thence North being along The West line of The said lot 4 -- 53 feet to The Northwest corner of The lot occupied and owned by Carl Burns. Thence West, being The North line of the said Burns lot produced, across lot No. 3 of The said subdivision, and Lot No. I of The said Addition, 81 feet to an iron Stake on the Northwesterly line of The said Lot No. I. Thence South Westerly, being along the line of The said Lot, 104.5 feet, to an iron Post, and continuing on The same line, 4 feet more or less, to The North Easterly Line of the Cement Walk. Thence South Easterly, being along The North Easterly Line of The said walk, 69 feet to a seam in The said walk, at The Westerly end of The Drive. Thence N 47°-30' 57.2 feet to an iron stake. Thence East 25 feet to an iron stake; Thence North 20 feet to an iron Stake. Thence East 50 feet to an iron Stake, and 58 feet more or less to The place of beginning.

Also —

Beginning at a point on The north line of the above described Lot, 17 feet West, of the North East Corner Thereof, and the said point being in line of one certain Fence. Thence North, being along the line of said Fence, 78 feet, more or less, to the South line of The lot owned and occupied by Chas. McCabe. Thence West, being along the South line of The said Mc Cabe's lot, 48 feet, more or less, to The West line of Lot No I, of the said Addition.

Thence South, being along the West line of the said Lot, 65 feet, more or less, to an iron Post, at The South End Thereof.

Thence Southwesterly, being along the line of The said Lot, 22.2 feet, to an iron stake, being a corner of The above described Lot, Thence East, being along the North line of the above described Lot, 64 feet to The place of beginning.

Surveyed by William Child C.S.

Recorded by Lloyd S. Jones C.S.
Feb. 1, 1934